

Attala
R 2007
4/76

MISSISSIPPI
 BOARD OF WATER COMMISSIONERS
 416 North State Street
 Jackson, Mississippi 39201

WATER WELL DRILLERS LOG

April 1976 Thomas & So Attala
 date well completed firm name county well located


LANDOWNER: <u>Larry Biley</u> <u>Kosciusko, Miss.</u> (mailing address)	description of formations encountered	from	to
	<u>SAND</u>	<u>0</u>	<u>30</u>
	<u>CHALK</u> <u>course SAND</u>	<u>30</u> <u>60</u>	<u>60</u> <u>72</u>

WELL LOCATION:
 sec. 1 T. 13N R. 6E
2 miles SW of Kos.
 (distance) (direction) (nearest town)

WELL PURPOSE:
 (home, irrigation, municipal, industrial)

- WELL COMPLETION DATA:
- (1) diameter (inches) 2
 - (2) total depth (feet) 72
 - (3) static water level (feet) 50 below top of ground
 - (4) casing pc 67
 (material) (depth)
2 (size) if telescope see back.
 - (5) screen 5 67
 (length) (depth to top)
2" slot pc
 (size) (material)
 - (6) pump 1/2 5
 (HP) (yield gpm)
elec
 (type power)
 - (7) electric log no
 (yes or no)
 - (8) how well bottom plugged part

DRILLERS REMARKS:

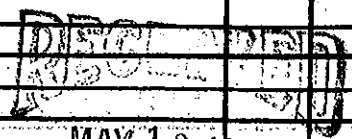

MAY 13 1976