

Attala
R 2012
5/181

MISSISSIPPI
BOARD OF WATER COMMISSIONERS
416 North State Street
Jackson, Mississippi 39201

WATER WELL DRILLERS LOG

MAY 1981 Thomas Attala
date well completed firm name county well located


LANDOWNER: Robert Nhill
Highway 12 W,
Kosciusko, MS
(mailing address)

WELL LOCATION:
sec. 2 T 13 N R 6 E
S W
3 miles SW of KOSI.
(distance) (direction) (nearest town)

WELL PURPOSE: Home
(home, irrigation, municipal, industrial)

WELL COMPLETION DATA:
(1) diameter (inches) 4
(2) total depth (feet) 263
(3) static water level (feet) 40 ^(below) _(above) top of ground.
(4) casing PVC 160 160
(material) (depth)
4 if telescope see back.
(size)
(5) screen open
(length) (depth to top)
(size) (material)
(6) pump 1/2 11
(HP) (yield gpm)
Ekr. Sub.
(type power)
(7) electric log NO
(yes or no)
(organization running log)
(8) how well bottom plugged open

description of formations encountered	from	to
<u>Red Dirt</u>	<u>0</u>	<u>15</u>
<u>CHALK & SAND</u>	<u>15</u>	<u>50</u>
<u>SAND</u>	<u>50</u>	<u>147</u>
<u>Black Dirt</u>	<u>147</u>	<u>174</u>
<u>Rock Stratter</u>	<u>174</u>	<u>178</u>
<u>Black Dirt</u>	<u>178</u>	<u>208</u>
<u>Rock & shell</u>	<u>208</u>	<u>220</u>
<u>Green SAND</u>	<u>220</u>	<u>263</u>

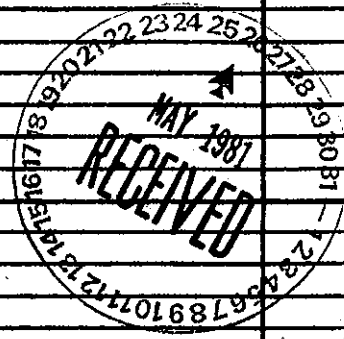

DRILLERS REMARKS: