

ATTALA

MISSISSIPPI BOARD OF WATER COMMISSIONERS

MS 21

3-31-62 WATER WELL DRILLERS LOG


CODED

Date: 3-31-1962, Driller: Layne-Central Co. County: Attala

(Name)

United Gas Pipe Line		Description & Color of Materials Sand, Clay, Red Clay, Shell, etc.	Thick- ness Feet	Depth Feet
(1) Owner of Land: <u>Company</u> (Name) <u>Kosciusko, Mississippi</u> (Address)		Red sandy clay	55	55
(2) Location: <u>1/4</u> , <u>1/4</u> , Sec. <u>15 T 3 R 7</u> <u> </u> miles <u> </u> of <u> </u> (distance) (direction) (Nearest Town)		blue clay ✓	35	90
(3) Topography: <u> </u> (Hilly) (Flat) (Level)		rock	2	92
(4) Purpose of Well: <u>Pipe line</u> (Domestic Irrigation Municipal, Industrial, Other)		hard shale	13	105
Information upon completion of well:		hard shale, stks sand	26	131
(1) Diameter <u>8"</u> inches.		rock	2	133
(2) Total Depth <u>372'</u> feet.		hard shale	17	150
(3) Water Level <u>157'</u> feet below top of ground.		sand	60	210
(4) Cased to <u>340'</u> , Size <u>8"</u>		sand, stks shale	50	260
(5) Screen: Size <u>4"</u> , Length <u>20'</u>		shale	6	266
(6) Were any formations sealed against pollution? <u>x</u> yes, <u> </u> no.		rock	3	269
If YES depth of formation <u>340'</u>		hard shale, stks sand	18	287
Why <u>Required</u>		rock	1	288
Drillers Remarks: <u> </u>		hard sand, stks sand rock	34	322
		fine sand	11	333
		sandy shale	7	340
		sand	28	368
		hard shale	7	375

CODED

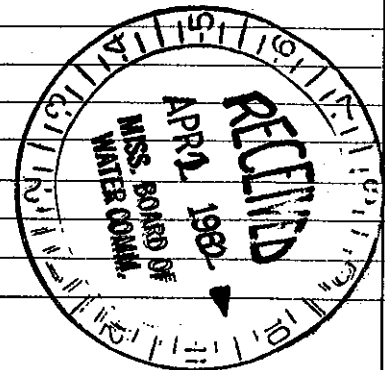

(Use Back Side)

Well No.

Mail this copy to Board of Water Commissioners 429 Miss. St. Jackson, Miss.