

ATTALA MISSISSIPPI BOARD OF WATER COMMISSIONERS

S 2000

520

WATER WELL DRILLERS LOG

7-18-60

Date: 7-18, 1960, Driller: Smith & Presley County, ATTALA

(Name)

(1) Owner of Land: CH Cotton
(Name)

R.H.B. 90 Kocinski's miss
(Address)

(2) Location: S 1/4 N 1/4 & S 1/4 NE 1/4 NE
1/4, 1/4, Sec. 23 T13R7

7 miles South HWY 35 of Kocinski
(distance) (direction) (Nearest Town)

(3) Topography: Hilly
(Hilly) (Flat) (Level)

(4) Purpose of Well: Domestic
(Domestic Irrigation
Municipal, Industrial, Other)

Description & Color of Materials Sand, Clay, Red Clay, Shell, etc.	Thick- ness Feet	Depth Feet
red sand clay	9	9
sand rock	1/2	9 1/2
red sand	17	26
White sand	54	80
dark brown clay	26	106
hard brown shale	2	108
brown clay	2	110
thin layers of shale		110
soft brown shale		
in and out of		
hard shale	10	120
hard shale	6	126
soft brown shale		
in and out of		
hard shale	14	140
shale mixed		FWL
with green sand	25	165
a coarse gray or white water sand	18	183
		Etc.

Information upon completion of well:

(1) Diameter 2" inches.

(2) Total Depth 183 feet.

(3) Water Level 86 feet below top of ground.

(4) Cased to 177, Size 2" to 1 1/4"


(5) Screen: Size 1 1/4", Length 6'

(6) Were any formations sealed against pollution?
 yes, no.

If YES depth of formation _____

Why _____

Drillers Remarks: _____

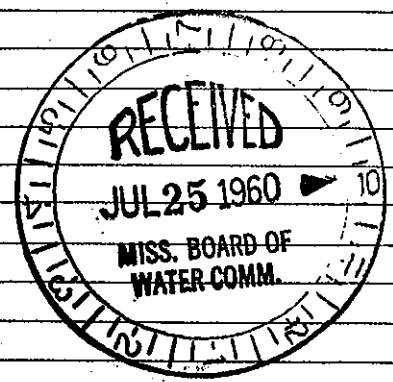

(Use Back Side)

Well No. 520

Mail this copy to Board of Water Commissioners 429 Miss. St. Jackson, Miss.