

ATTALA MISSISSIPPI BOARD OF WATER COMMISSIONERS

S ~~2~~
5-7-62

WATER WELL DRILLERS LOG

526

Date: 5-7, 1962, Driller: Thomas & Son County: Attala
(Name)

	Description & Color of Materials Sand, Clay, Red Clay, Shell, etc.	Thick- ness Feet	Depth Feet
(1) Owner of Land: <u>T. K. Jennings</u> (Name)			
<u>Kosciusko, Miss</u> (Address)	<u>Red Clay</u>	<u>15</u>	<u>0-15</u>
<u>SE 1/4 NW 1/4 + NE 1/4 SW 1/4 + NW 1/4 SE 1/4</u> (2) Location: <u>1/4, 1/4, Sec. 27 T13R7,</u>	<u>SAND</u>	<u>48</u>	<u>15-63</u>
<u>9</u> miles <u>South</u> , of <u>Kosciusko</u> (distance) (direction) (Nearest Town)	<u>Sparta</u>		
(3) Topography: <u>Hilly</u> (Hilly) (Flat) (Level)			
(4) Purpose of Well: <u>Domestic</u> (Domestic Irrigation Municipal, Industrial, Other)			


Information upon completion of well:

- (1) Diameter 2 inches.
- (2) Total Depth 63 feet.
- (3) Water Level 35 feet below top of ground.
- (4) Cased to 55, Size 2.
- (5) Screen: Size 60G, Length 6 Ft.
- (6) Were any formations sealed against pollution?
 yes, no.

If YES depth of formation _____

Why _____

Drillers Remarks: _____

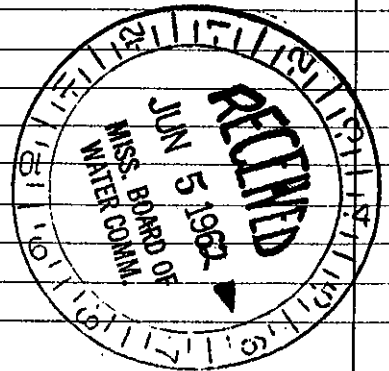

(Use Back Side)

Well No.

Mail this copy to Board of Water Commissioners 429 Miss. St. Jackson, Miss