

ATTALA

MISSISSIPPI BOARD OF WATER COMMISSIONERS

S ~~308~~

9-15-62

WATER WELL DRILLERS LOG


528

Date: 9-15-1962

Driller: Smith Presley County Attala

(Name)

		Description & Color of Materials Sand, Clay, Red Clay, Shell, etc.	Thick- ness Feet	Depth Feet
(1) Owner of Land: <u>Matthews Edwards</u> (Name)		red clay &	5	50
<u>B3 Box 3A Kossincks</u> (Address)		red sand	14	17
(2) Location: <u>1/2 1/4, NW 1/4</u> Sec. <u>6</u> T <u>13</u> R <u>7</u>		white clay	6	23
<u>3</u> miles <u>SE</u> of <u>Kossincks</u> (distance) (direction) (Nearest Town)		blue clay	57	80
(3) Topography: <u>Hilly</u> (Hilly) (Flat) (Level)		thin rocks		
(4) Purpose of Well: <u>domestic</u> (Domestic Irrigation Municipal, Industrial, Other)		about	2"	
Information upon completion of well:		black clay and shale	3	83
(1) Diameter <u>2</u> inches.		red shale black clay mixture	13	96
(2) Total Depth <u>176</u> feet.		red shale	3	99
(3) Water Level <u>80</u> feet below top of ground.		rock series gray and red mixture		
(4) Cased to <u>170</u> , Size <u>2"</u>		2 and 4 inches thick	6	105
(5) Screen: Size <u>1/4</u> , Length <u>6'</u>		black soft shale with a trace of sand	16	121
(6) Were any formations sealed against pollution? yes, <input checked="" type="checkbox"/> no.		red shale	6	127
If YES depth of formation _____		black shale	3	130
Why _____		red shale	16	146
Drillers Remarks: _____		black shale with trace sand	6	152
		sand with trace of shale	4	156
		white sand medium grade	20	176
				Etan
				35
				Well No.

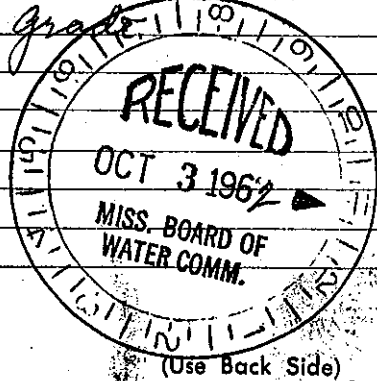

Mail this copy to Board of Water Commissioners 429 Miss. St. Jackson, Miss.