

ATTALA

MISSISSIPPI BOARD OF WATER COMMISSIONERS

S 29


WATER WELL DRILLERS LOG

6-22-62

Date: 6-22, 1962, Driller: Hearn Drilling County Attala

(Name)

(1) Owner of Land (Name)	Description & Color of Materials Sand, Clay, Red Clay, Shell, etc.	Thick- ness Feet	Depth Feet
<u>A. N. Parkinson</u> (Name) <u>S. Huntington St, Kosciusko</u> (Address)	<u>Yellow clay</u>	<u>5</u>	<u>5</u>
(2) Location: <u>SE 1/4, NW 1/4, Sec. 11, T. 3 R. 7</u>	<u>White clay</u>	<u>3</u>	<u>8</u>
<u>2 1/2</u> miles <u>South</u> of <u>Kosciusko</u> (distance) (direction) (Nearest Town)	<u>Brown clay</u>	<u>24</u>	<u>32</u>
(3) Topography: <u>Hilly</u>	<u>Rock</u>	<u>2</u>	<u>34</u>
(4) Purpose of Well: <u>Domestic</u>	<u>Hard Grey clay shale</u>	<u>14</u>	<u>48</u>
(Domestic Irrigation Municipal, Industrial, Other)	<u>Rock</u>	<u>6</u>	<u>54</u>
Information upon completion of well:	<u>Lime stone Green</u>	<u>16</u>	<u>70</u>
(1) Diameter <u>2</u> inches.	<u>Limestone Green</u>	<u>10</u>	<u>80</u>
(2) Total Depth <u>279</u> feet.	<u>Rock</u>	<u>5</u>	<u>85</u>
(3) Water Level <u>100ft</u> feet below top of ground.	<u>Green limestone</u>	<u>13</u>	<u>98</u>
(4) Cased to <u>253</u> , Size <u>2</u>	<u>Light sand</u>	<u>19</u>	<u>117</u>
(5) Screen: Size <u>1/4</u> , Length <u>4ft</u>	<u>Green-Brown sand</u>	<u>20</u>	<u>137</u>
(6) Were any formations sealed against pollution?	<u>Fine green shale</u>	<u>43</u>	<u>180</u>
_____ yes, <input checked="" type="checkbox"/> no.	<u>Rock</u>	<u>5</u>	<u>185</u>
If YES depth of formation _____	<u>Green sand</u>	<u>24</u>	<u>207</u>
Why _____	<u>Rock</u>	<u>8</u>	<u>215</u>
Drillers Remarks: <u>All strata of</u>	<u>Rock</u>	<u>45</u>	<u>260</u>
<u>Sand above Acid</u>	<u>Lime stone</u>	<u>6</u>	<u>266</u>
	<u>Grey pepper sand</u>	<u>4</u>	<u>270</u>
	<u>Light pepper sand</u>	<u>13</u>	<u>283</u>

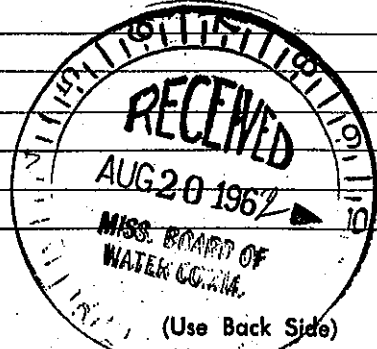

Well No.

Mail this copy to Board of Water Commissioners 429 Miss. St. Jackson, Miss.