

ATTALA
S 2002 WATER WELL DRILLERS LOG

Date: 1-20-64, Driller: Thomas & Son County ATTALA
(Name)

	Description & Color of Materials Sand, Clay, Red Clay, Shell, etc.	Thick- ness Feet	Depth Feet
(1) Owner of Land: <u>Mr. Horn</u> <u>Rt. 4</u> <u>Kosciusko, Miss</u> <small>(Name)</small> <small>(Address)</small>	<u>Red CLAY</u>	<u>10</u>	
(2) Location: <u>NE 1/4, NE 1/4, Sec. 12 T13R7</u> <u>3</u> miles <u>S</u> of <u>Kosciusko</u> <small>(distance)</small> <small>(direction)</small> <small>(Nearest Town)</small>	<u>BLACK DIRT</u>	<u>25</u>	<u>10</u>
(3) Topography: <u>(Hilly)</u> (Flat) (Level)	<u>SHELL & ROCK</u>	<u>25</u>	<u>35</u>
(4) Purpose of Well: <u>(Domestic)</u> Irrigation Municipal, Industrial, Other	<u>GREEN SAND</u>	<u>45</u>	<u>60</u>
	<u>CHALK w/sand-lime ROCK</u>	<u>22</u>	<u>105</u>
	<u>Coarse Grey SAND</u>	<u>20</u>	<u>127</u>

Information upon completion of well:

- (1) Diameter 2 inches.
- (2) Total Depth 147 feet.
- (3) Water Level 40 feet below top of ground.
- (4) Cased to 141, Size 2"
- (5) Screen: Size 85/100 Length 5 Ft.
- (6) Were any formations sealed against pollution?
no yes, no.

If YES depth of formation _____

Why _____


Drillers Remarks: We Pumped

The Green SAND

open, But couldn't

Drink Water For Acid

Retain this copy for your office files. Other chemicals. Have
sent some to state. To be checked.

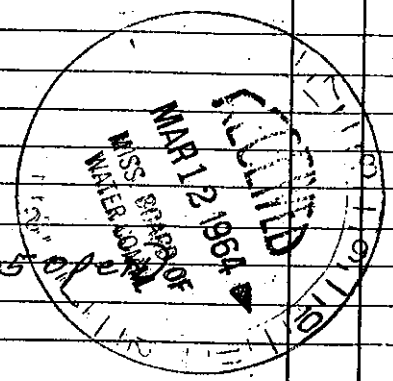

Well No. _____

(Use Back Side)