

ATTALA

S 2003 WATER WELL D.

1-14-66

Date: 1-14, 1966, Driller: Thomas & Son

(Name)

(1) Owner of Land: Allen  
 RT+H (Name)  
Kosciusko, Miss  
 (Address)

(2) Location: NW 1/4, NW 1/4, Sec. 15 T13R7,  
1/2 miles S of Kosciusko  
 (distance) (direction) (Nearest Town)

(3) Topography: (Hilly) (Flat) (Level)

(4) Purpose of Well: Domestic Irrigation  
 Municipal, Industrial, Other)

Description & Color of Materials  
Sand, Clay, Red Clay, Shell, etc.

Feet

Red Clay	20	
Black Dirt	40	20
Rock & shell	30	60
Green Sand	28	90

Information upon completion of well:

(1) Diameter 2 inches.

(2) Total Depth 119 feet.

(3) Water Level 55 feet below top of ground.

(4) Cased to 84', Size 2"


(5) Screen: Size \_\_\_\_\_, Length \_\_\_\_\_.

(6) Were any formations sealed against pollution?  
 \_\_\_\_\_ yes, X no.

If YES depth of formation \_\_\_\_\_

Why \_\_\_\_\_

Drillers Remarks: \_\_\_\_\_

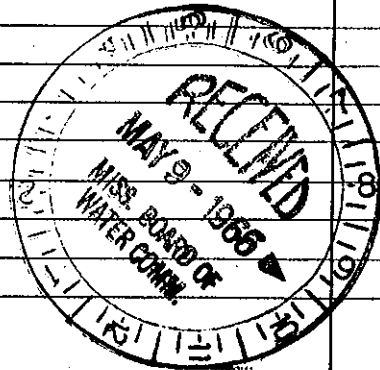

(Use Back Side)

Well No.

Mail this copy to Board of Water Commissioners 429 Miss. St. Jackson, Miss.