

Attala
5 2015
8-27-68

MISSISSIPPI
 BOARD OF WATER COMMISSIONERS
 416 North State Street
 Jackson, Mississippi 39201

WATER WELL DRILLERS LOG

8-27 1968 Thomson Attala
 date well completed firm name county well located

LANDOWNER: JAMISON
Rt 4
Kosciusko, Miss.
 (mailing address)


WELL LOCATION:
 sec. 12 T. 13 N R. 7 E
3 miles S.E. of Kos.
 (distance) (direction) (nearest town)

WELL PURPOSE:
 (home, irrigation, municipal, industrial)

WELL COMPLETION DATA:

(1) diameter (inches) 2
 (2) total depth (feet) 145
 (3) static water level (feet) 78 below above
 top of ground.
 (4) casing P.V. 91
 (material) (depth)
2 If telescope see back.
 (size)
 (5) screen open
 (length) (depth to top)
 (size) (material)
 (6) pump 1 5
 (HP) (yield gpm)
elec.
 (type power)
 (7) electric log no
 (yes or no)
 (organization running log)
 (8) how well bottom plugged

| description of formations encountered | from | to |
|---|------------|------------|
| <u>pipe clay</u> | <u>0</u> | <u>23</u> |
| <u>black dirt</u> | <u>29</u> | <u>70</u> |
| <u>Rock & shell</u> | <u>70</u> | <u>73</u> |
| <u>Green Sand</u> | <u>93</u> | <u>100</u> |
| <u>Solid Rock</u> | <u>100</u> | <u>102</u> |
| <u>Green Sand</u> | <u>102</u> | <u>145</u> |
| <u>w/ shls shell & some black dirt.</u> | | |

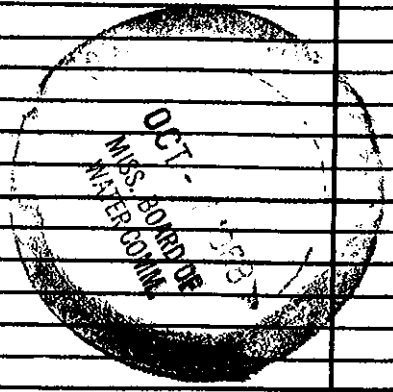

DRILLERS REMARKS: