

AHALA
79-62
Date: 8-15, 1962

WATER WELL DRILL LOG

CODED

Driller: Thomas & Son, Ahala County, Ahala
(Name)


(1) Owner of Land: James Gladney
(Name)
Kosciusko, Miss
(Address)
7 13N
(2) Location: SE 1/4, NE 1/4, Sec. 19, T9 R 8 E
8 miles South E. of Kosciusko
(distance) (direction) (Nearest Town)
(3) Topography: Hilly
(Hilly) (Flat) (Level)
(4) Purpose of Well: Domestic
(Domestic Irrigation
Municipal, Industrial, Other)

Description & Color of Materials Sand, Clay, Red Clay, Shell, etc.	Thick- ness Feet	Depth Feet
Red Clay	14	0-14
Chalk	2.6	14-16.6
Black Dirt	30	16.6-46.6
Shell	2.4	46.6-49
Green Sand	30	49-79

Information upon completion of well:

(1) Diameter 2 inches.
(2) Total Depth 127 feet.
(3) Water Level 65 feet below top of ground.
(4) Cased to 94', Size 2
(5) Screen: Size 2 1/2", Length 10'
(6) Were any formations sealed against pollution?
_____ yes, no.
If YES depth of formation _____
Why _____
Drillers Remarks: _____

CODED

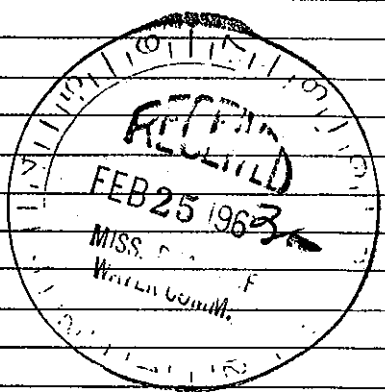

(Use Back Side)

Well No.

Return this log to your office files.