

AYYALA

MISSISSIPPI BOARD OF WATER COMMISSIONERS

T 10  
7-30-63

WATER WELL DRILLERS LOG **CODED**

Date: 7-30, 1963, Driller: Therrell Drilling Co., S. County Pittala  
(Name)

(1) Owner of Land: Barnett  
(Name)  
Bascom St  
(Address)

(2) Location: 18 13N8E Sec. T R. R  
6 miles 36 of Bascom  
(distance) (direction) (Nearest Town)

(3) Topography: L  
(Hilly) (Flat) (Level)

(4) Purpose of Well: Domestic  
(Domestic Irrigation  
Municipal, Industrial, Other)

Description & Color of Materials Sand, Clay, Red Clay, Shell, etc.	Thick- ness Feet	Depth Feet
Clay	20	20
Beach + Hard	60	80
Rock	5	85
Spice	3	88
Rock	2	90
Beige Clay	7	97
Rock	2	104
Green Sand & Shells	21	125
Limestone Rock	10	135
Green Sand (Light)	25	160
Shale + Sand mix	20	180
Light Blue Sand	18	228
Coarse Light Blue	22	250

Information upon completion of well:

- (1) Diameter 2 inches.
- (2) Total Depth 250 feet.
- (3) Water Level 10 1/2 feet below top of ground.
- (4) Cased to 180, Size 2
- (5) Screen: Size 2 1/2", Length 5'
- (6) Were any formations sealed against pollution?  
\_\_\_\_\_ yes, \_\_\_\_\_ no.

If YES depth of formation \_\_\_\_\_

Why \_\_\_\_\_


Drillers Remarks: Air Well

Fair Production

will flow sea

Sands well

**CODED**

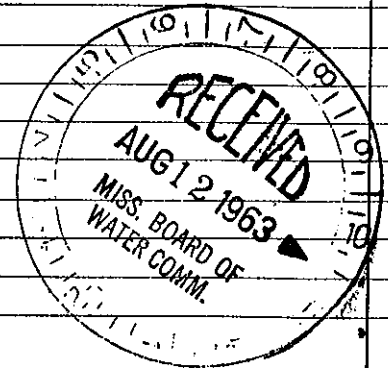

(Use Back Side)

Well No.

Mail this copy to Board of Water Commissioners 429 Miss. St. Jackson, Mis