

T 22 ATTALA WATER WELL DRILLERS LOG

3-17-62

T 22

Date: 3-17, 1962, Driller: Thomas & Son Drilling Co. ATTALA

(Name)

(1) Owner of Land:	Description & Color of Materials Sand, Clay, Red Clay, Shell, etc.	Thick- ness Feet	Depth Feet
Roy Pettit (Name) Kosciusko, Miss (Address)	Red clay SAND	20 26	0-20 20-46
(2) Location: 1/4, NE 1/4, Sec. 8 T13R 8, 8 miles S.E. of Kosciusko (distance) (direction) (Nearest Town)			
(3) Topography: Hilly (Hilly) (Flat) (Level)			
(4) Purpose of Well: Domestic (Domestic Irrigation Municipal, Industrial, Other)	Coded		


Information upon completion of well:

- (1) Diameter 2 inches.
- (2) Total Depth 46 feet.
- (3) Water Level 32 feet below top of ground.
- (4) Cased to 40, Size 2
- (5) Screen: Size 60, Length 6 Ft.
- (6) Were any formations sealed against pollution?
yes, no.

If YES depth of formation _____

Why _____

Drillers Remarks: _____

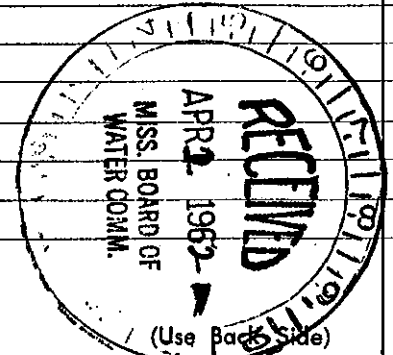

Well No.

Mail this copy to Board of Water Commissioners 429 Miss. St. Jackson, Mis