

ATTALA MISSISSIPPI BOARD OF WATER COMMISSIONERS

WATER WELL DRILLERS LOG

12-1-60

T 300

Date: 12-1-, 1960, Driller: Smith & Parsley County ATTALA  
(Name)

(1) Owner of Land: REXAL Gregory  
(Name)  
R.4 Box 173 Kosciusko  
W 2 NW 4 NE 4 2 NE 4 NW 4  
(Address)

(2) Location: 1/4, 1/4, Sec. 12 T12R8  
10 miles SE of Kosciusko  
(distance) (direction) (Nearest Town)

(3) Topography: HILLY  
(Hilly) (Flat) (Level)

(4) Purpose of Well: DOMESTIC  
(Domestic Irrigation  
Municipal, Industrial, Other)

Description & Color of Materials Sand, Clay, Red Clay, Shell, etc.	Thick- ness Feet	Depth Feet
RED CLAY	7	7
SAND ROCK	6	13
WHITE CLAY	6	24
SAND ROCK	3	27
BROWN SAND MIXED WITH BLACK	18	45
Mixture of brown sand and brown clay	20	65
Another clay hard part	16	81
6"		
Sand brown clay mixture	20	101
Solid clay	31	132
hard shell brown sand a greenish mixture	8"	
16	148	
White water sand	26	175

Information upon completion of well:

(1) Diameter 2" inches.

(2) Total Depth 175 feet.

(3) Water Level 84 feet below top of ground.

(4) Cased to 147, Size 2


(5) Screen: Size 1/4, Length 6'

(6) Were any formations sealed against pollution?  
\_\_\_\_\_ yes, X no.

If YES depth of formation \_\_\_\_\_

Why \_\_\_\_\_

Drillers Remarks: \_\_\_\_\_

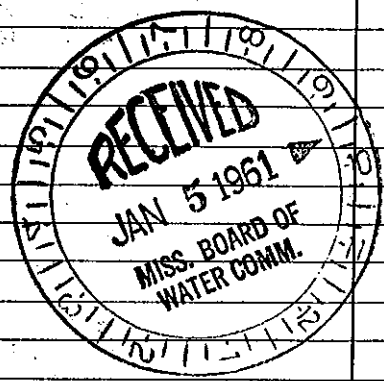

(Use Back Side)

Well No. 7

Mail this copy to Board of Water Commissioners 429 Miss. St. Jackson, Miss.