

# ATTALA WATER WELL DRILLERS LOG

Date: 11-3-63<sup>2000</sup>, 1962, Driller: Thomas & Son County ATTALA  
(Name)

<p>(1) Owner of Land: <u>Clinton Boyd</u>  <small>(Name)</small>  <u>Kosciusko, Miss</u>  <small>(Address)</small></p> <p>(2) Location: <u>1/4 SW 1/4, Sec. 21 T13R 8,</u>  <u>10</u> miles <u>SOUTH EAST</u>, of <u>Kosciusko</u>  <small>(distance) (direction) (Nearest Town)</small></p> <p>(3) Topography: <u>Hilly</u>  <small>(Hilly) (Flat) (Level)</small></p> <p>(4) Purpose of Well: <u>Domestic</u>  <small>(Domestic Irrigation  Municipal, Industrial, Other)</small></p>	<table border="1" style="width: 100%; border-collapse: collapse;"> <thead> <tr> <th style="width: 80%;">Description &amp; Color of Materials Sand, Clay, Red Clay, Shell, etc.</th> <th style="width: 10%;">Thick- ness Feet</th> <th style="width: 10%;">Depth Feet</th> </tr> </thead> <tbody> <tr> <td>Red Clay</td> <td style="text-align: center;">20</td> <td style="text-align: center;">0</td> </tr> <tr> <td>BLACK dirt</td> <td style="text-align: center;">40</td> <td style="text-align: center;">20</td> </tr> <tr> <td>Rock &amp; shell</td> <td style="text-align: center;">34</td> <td style="text-align: center;">60</td> </tr> <tr> <td>Shell &amp; SAND</td> <td style="text-align: center;">6</td> <td style="text-align: center;">94</td> </tr> <tr> <td>Rock (Hard)</td> <td style="text-align: center;">19"</td> <td style="text-align: center;">99</td> </tr> <tr> <td>Green sand &amp; shell</td> <td></td> <td style="text-align: center;">100 1/2</td> </tr> <tr> <td></td> <td></td> <td style="text-align: center;">133</td> </tr> </tbody> </table>	Description & Color of Materials Sand, Clay, Red Clay, Shell, etc.	Thick- ness Feet	Depth Feet	Red Clay	20	0	BLACK dirt	40	20	Rock & shell	34	60	Shell & SAND	6	94	Rock (Hard)	19"	99	Green sand & shell		100 1/2			133
Description & Color of Materials Sand, Clay, Red Clay, Shell, etc.	Thick- ness Feet	Depth Feet																							
Red Clay	20	0																							
BLACK dirt	40	20																							
Rock & shell	34	60																							
Shell & SAND	6	94																							
Rock (Hard)	19"	99																							
Green sand & shell		100 1/2																							
		133																							

Information upon completion of well:


- (1) Diameter 2 inches.
- (2) Total Depth 133 feet.
- (3) Water Level 80 feet below top of ground.
- (4) Cased to 94, Size 2
- (5) Screen: Size \_\_\_\_\_, Length \_\_\_\_\_
- (6) Were any formations sealed against pollution?  
 \_\_\_\_\_ yes,  no.

If YES depth of formation \_\_\_\_\_

Why \_\_\_\_\_

Drillers Remarks: \_\_\_\_\_  
 \_\_\_\_\_  
 \_\_\_\_\_

~~Keep this copy for your office files.~~

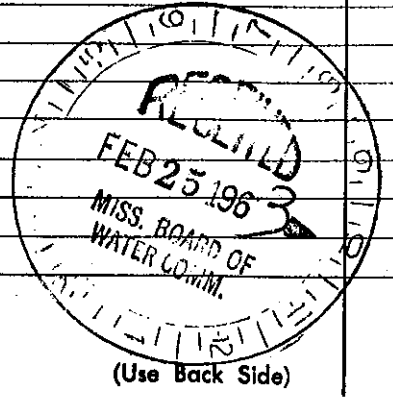

Well No.