

ATTALA MISSISSIPPI BOARD OF WATER COMMISSIONERS

T 2002
2-17-64

WATER WELL DRILLERS LOG

Date: 2-17, 1964, Driller: Thomstson County ATTALA

(Name)

		Description & Color of Materials Sand, Clay, Red Clay, Shell, etc.	Thick- ness Feet	Depth Feet
(1) Owner of Land:	<u>Mr. Tollison</u> (Name)	<u>Red Clay</u>	<u>21</u>	<u>0</u>
	<u>Rt. # 5 Kosciusko</u> (Address)	<u>BLACK DIRT</u>	<u>24</u>	<u>21</u>
(2) Location:	<u>SE 1/4, SW 1/4, Sec. 6 T13R8</u>	<u>Rock & shell</u>	<u>20</u>	<u>45</u>
	<u>5 miles SE</u> of <u>Kosciusko</u> (distance) (direction) (Nearest Town)	<u>Green Sand & Shell</u>	<u>19</u>	<u>65</u>
		<u>Grey Sand</u>	<u>23</u>	<u>84</u>
(3) Topography:	<input checked="" type="radio"/> (Hilly) <input type="radio"/> (Flat) <input type="radio"/> (Level)			
(4) Purpose of Well:	<input checked="" type="radio"/> (Domestic) <input type="radio"/> (Irrigation) <input type="radio"/> (Municipal) <input type="radio"/> (Industrial) <input type="radio"/> (Other)			

Information upon completion of well:


- (1) Diameter 2 inches.
- (2) Total Depth 107 feet.
- (3) Water Level 62 feet below top of ground.
- (4) Cased to 84, Size 2
- (5) Screen: Size _____, Length _____.
- (6) Were any formations sealed against pollution?
_____ yes, no.

If YES depth of formation _____

Why _____

Drillers Remarks: _____

Retain this copy for your office files.

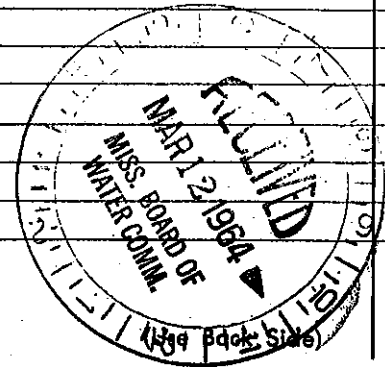

Well No.