

ATTALA
T 2059
2-67

MISSISSIPPI
BOARD OF WATER COMMISSIONERS
416 North State Street
Jackson, Mississippi 39201

WATER WELL DRILLERS LOG

2-20 1967 Thomas Son ATTALA
date well completed firm name county well located

LANDOWNER: Charlie Lee
Rt. 4
Kosciusko, Miss.
(mailing address)

WELL LOCATION:
sec. 19 T 13 N R 8 E
S W
7 miles S.E. of Kosciusko
(distance) (direction) (nearest town)

WELL PURPOSE: Home
(home, irrigation, municipal, industrial)

WELL COMPLETION DATA:

(1) diameter (inches) 2

(2) total depth (feet) 243

(3) static water level (feet) 150 below top of ground.

(4) casing Galv. 201 ft.
(material) (depth)
2" if telescope see back.
(size)


(5) screen None
(length) (depth to top)
(size) (material)

(6) pump 3/4 4
(HP) (yield gpm)
Elec Rod Pump
(type power)

(7) electric log No
(yes or no)
(organization running log)

(8) how well bottom plugged

description of formations encountered	from	to
CLAY	0	10
Red Sand	10	60
White Chalky Sand	60	149
B. Dirt C	149	123
Rock & Shell	123	201
Green Sand	205	243

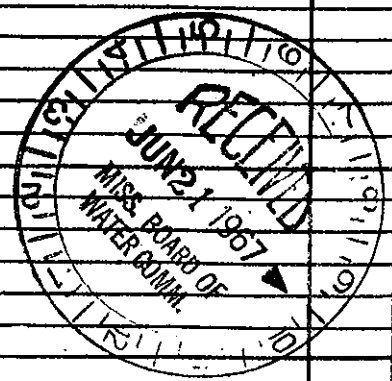

DRILLERS REMARKS: