

Attala
 + 2008
 3-67

MISSISSIPPI
 BOARD OF WATER COMMISSIONERS
 416 North State Street
 Jackson, Mississippi 39201

WATER WELL DRILLERS LOG

3-7 1967 Thomas & Son Attala
 date well completed firm name county well located


LANDOWNER: manuel Cotton
St. H
Kosciusko, Miss.
 (mailing address)

WELL LOCATION:
 sec. 19 T. 13 N R. 9 E
6 1/2 miles S.E. of Kos.
 (distance) (direction) (nearest town)

WELL PURPOSE: Home
 (home, irrigation, municipal, industrial)

- WELL COMPLETION DATA:
- (1) diameter (inches) 2
 - (2) total depth (feet) 175
 - (3) static water level (feet) 99 ^{below} above top of ground.
 - (4) casing Galv. 120'
 (material) (depth)
2" if telescope see back.
 (size)
 - (5) screen NONE
 (length) (depth to top)
 (size) (material)
 - (6) pump 1 1/2 6
 (HP) (yield gpm)
Elec.
 (type power)
 - (7) electric log NO
 (yes or no)
 (organization running log)
 - (8) how well bottom plugged

description of formations encountered	from	to
Red Clay	0	8
Red Sand	8	20
Course White Sand	20	36
Real Chalky Sand	36	70
wouldn't Pump		
Black Dirt	70	112
Rocky Shell	112	130
Green Sand	130	175

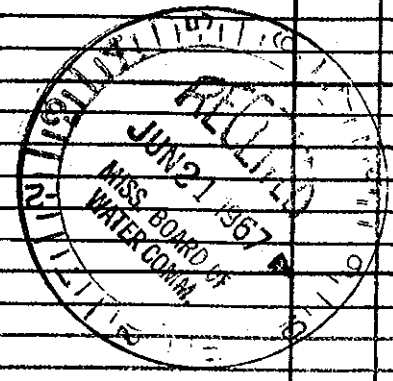

DRILLERS REMARKS: