

Benton
A16
3-66

MISSISSIPPI
BOARD OF WATER COMMISSIONERS
416 North State Street
Jackson, Mississippi 3920

CODED

WATER WELL DRILLERS LOG

3-15 1966 Robert M. Wilson Benton
date well completed film name county well located


LANDOWNER:	description of formations encountered	from	to
Arthur Carpenter	Red Sand	0	20
Michigan City	Blue clay white sand	20	30
Miss.	White sand	30	50
(mailing address)	White sand & clay (3ft.)	50	60
	White Sand	60	78

WELL LOCATION:
sec. 26 T-1 N R-1 E
1/2 miles S of Mich City
(distance) (direction) (nearest town)

WELL PURPOSE: Home
(home, irrigation, municipal, industrial)

- WELL COMPLETION DATA:
- (1) diameter (inches) 4"
 - (2) total depth (feet) 78
 - (3) static water level (feet) 40 ^{below} above top of ground.
 - (4) casing Plastic 70
(material) (depth)
4" If telescope see back.
(size)
 - (5) screen 8' 70'
209au (length) (depth to top)
4" Gravel Inc Slotted pipe
(size) (material)
 - (6) pump 1/2
(HP) (yield gpm)
Elect.
(type power)
 - (7) electric log NO
(yes or no)
(organization running log)
 - (8) how well bottom plugged 4"
Plastic cap

CODED

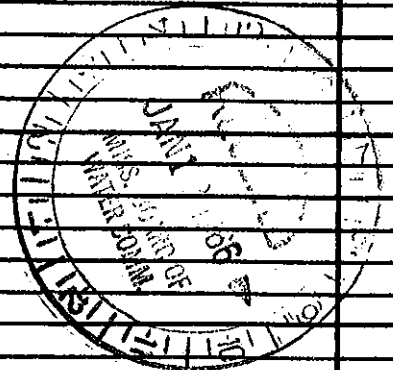

DRILLERS REMARKS: