

Benton
A17
2-67
2-21 1967

MISSISSIPPI
 BOARD OF WATER COMMISSIONERS
 416 North State Street
 Jackson, Mississippi 39201

WATER WELL DRILLERS LOG **CODED**

date well completed 1967 firm name Robert Wilson county well located Benton

LANDOWNER: United Community
action Committee
Midland Miss (Searcy)
 (mailing address)

| description of formations encountered | from | to |
|---------------------------------------|-----------|------------|
| <u>Red Clay</u> | <u>0</u> | <u>10</u> |
| <u>Red Sand</u> | <u>10</u> | <u>50</u> |
| <u>White Clay</u> | <u>50</u> | <u>60</u> |
| <u>White Sand</u> | <u>60</u> | <u>120</u> |

WELL LOCATION:
 sec. 21 T. 1 N. R. 1 E. W. 4
3 miles W of Michigan City
 (distance) (direction) (nearest town)

WELL PURPOSE:
 (home, irrigation, municipal, industrial)

WELL COMPLETION DATA:

(1) diameter (inches) 4

(2) total depth (feet) 120

(3) static water level (feet) 60 below top of ground.

(4) casing plastic, 116
 (material) (depth)
4" if telescope see back.
 (size)


(5) screen 4, 116
 (length) (depth to top)
4", brass pack
 (size) (material)

(6) pump 1/2, 10
 (HP) (yield gpm)
Elect.
 (type power)

(7) electric log yes or no
 (organization running log)

(8) how well bottom plugged 4"
plastic cap

CODED

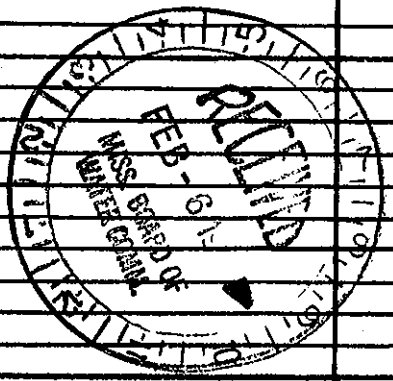

DRILLERS REMARKS: