

Benton
 A18
 3-67

MISSISSIPPI
 BOARD OF WATER COMMISSIONERS
 416 North State Street
 Jackson, Mississippi 39201

WATER WELL DRILLERS LOG

3-24-1967 Robert Wilson Benton
 date well completed firm name county well located

LANDOWNER: Tom Robinson
 Michigan City
 Miss.
 (mailing address)

description of formations encountered	from	to
Red clay		0
Red Sand	10	60
Red Sand white clay	60	70
White sand	70	110


CODED

WELL LOCATION:
 sec. 20 T. 1 N. R. 1 E.
 S. W.
 3 miles W of M. City
 (distance) (direction) (nearest town)

WELL PURPOSE:
 (home, irrigation, municipal, industrial)

- WELL COMPLETION DATA:
- diameter (inches) 4"
 - total depth (feet) 110'
 - static water level (feet) 20' below top of ground.
 - casing (material) plastic, (depth) 106'
 - screen (length) 4', (depth to top) 106'
 - screen (size) 4", (material) Ground Pack
 - pump (HP) 1/2, (yield gpm) 10
 - (type power) Elect.
 - electric log (yes or no)
 - (organization running log)
 - how well bottom plugged 4" plastic cap

CODED

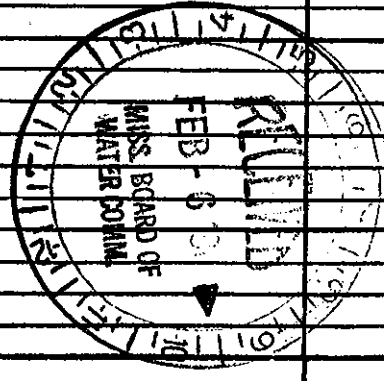

DRILLERS REMARKS: