

Benton
~~AI9~~
 6-67

MISSISSIPPI
 BOARD OF WATER COMMISSIONERS
 416 North State Street
 Jackson, Mississippi 39201

WATER WELL DRILLERS LOG

CODED

6-12 1967 *Robert Wilson* *Benton*
 date well completed film name county well located

LANDOWNER: *Carga Clardy*
Michigan City
Miss.
 (mailing address)


description of formations encountered	from	to
<i>Red clay Red sand</i>	<i>0</i>	<i>10</i>
<i>Red sand</i>	<i>10</i>	<i>50</i>
<i>Red sand white clay</i>	<i>50</i>	<i>60</i>
<i>White clay white sand</i>	<i>60</i>	<i>70</i>
<i>White sand</i>	<i>70</i>	<i>120</i>

WELL LOCATION:
 sec. 22 T 1 N W R 1 E W
3 miles W of Michigan City
 (distance) (direction) (nearest town)

WELL PURPOSE:
 (home, irrigation, municipal, industrial)

- WELL COMPLETION DATA:
- (1) diameter (inches) 4"
 - (2) total depth (feet) 120'
 - (3) static water level (feet) 70' below above top of ground.
 - (4) casing plastic, 116'
 (material) (depth)
4" If telescope see back.
 (size)
 - (5) screen 116'
 (length) (depth to top)
4, brass pack
 (size) (material)
 - (6) pump 1/2, 10
 (HP) (yield gpm)
Elect.
 (type power)
 - (7) electric log yes or no
 (organization running log)
 - (8) how well bottom plugged 2"
plastic cap

CODED

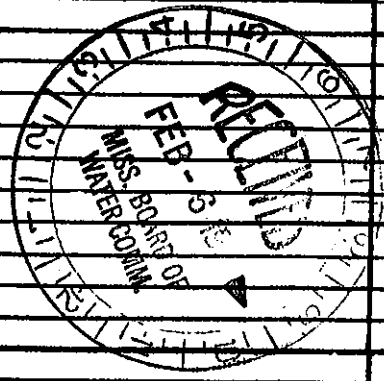

DRILLERS REMARKS: