

BENTON
A 21
9-67

MISSISSIPPI
BOARD OF WATER COMMISSIONERS
416 North State Street
Jackson, Mississippi 39201

WATER WELL DRILLERS LOG

CODED

9-22-1967 Robert Wilson
date well completed firm name county well located

LANDOWNER: Claude Finacker
Michigan City
Miss.
(mailing address)

description of formations encountered	from	to
Red clay Red sand	0	10
Red sand	10	20
Red sand white clay	20	30
White sand	30	40
White sand white clay	40	60
White sand	60	80

WELL LOCATION:
sec. 24 T 1 N R 1 E W
Exact location unknown
(distance) miles (direction) of (nearest town)

WELL PURPOSE:
(home, irrigation, municipal, industrial)

WELL COMPLETION DATA:

(1) diameter (inches) 4"

(2) total depth (feet) 80'

(3) static water level (feet) 30' below top of ground

(4) casing Plastic 76' (material) (depth)
4" (size) If telescope see back.

(5) screen 4' (length) 76' (depth to top)
4" (size) Gravel pack (material)


(6) pump 1/2 (HP) 10 (yield gpm)
Elect. (type power)

(7) electric log (yes or no)

(organization running log)

(8) how well bottom plugged 4"
Plastic cap

CODED

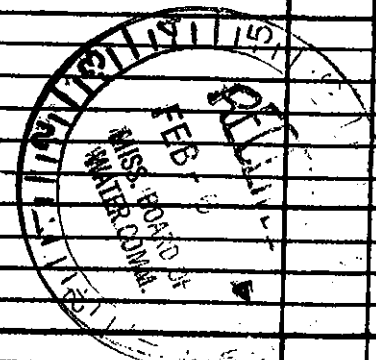

DRILLERS REMARKS: