

Benton
A 22
11-67

MISSISSIPPI
 BOARD OF WATER COMMISSIONERS
 416 North State Street
 Jackson, Mississippi 39201

WATER WELL DRILLERS LOG

CODED

11-27 19 *67* *Robert Wilson*
 date well completed firm name county well located

LANDOWNER: *Harold Bailey*
Michigan City
Miss.
 (mailing address)


| description of formations encountered | from | to |
|---------------------------------------|-----------|-----------|
| <i>Red clay Red Sand</i> | <i>0</i> | <i>20</i> |
| <i>White Clay White Sand</i> | <i>20</i> | <i>30</i> |
| <i>White Sand</i> | <i>30</i> | <i>65</i> |

WELL LOCATION:
 sec. *25* T-*1* N-*1* R-*1* E-*1*
2 miles *S* of *M. City*
 (distance) (direction) (nearest town)

WELL PURPOSE:
 (home, irrigation, municipal, industrial)

- WELL COMPLETION DATA:
- (1) diameter (inches) *4"*
 - (2) total depth (feet) *65'*
 - (3) static water level (feet) *30'* below top of ground
 - (4) casing *plastic*, *61'*
 (material) (depth)
4" If telescope see back.
 (size)
 - (5) screen *4'*, *61'*
 (length) (depth to top)
4, *Gravel Pack*
 (size) (material)
 - (6) pump *1/2*, *10*
 (HP) (yield gpm)
Elect.
 (type power)
 - (7) electric log *✓*
 (yes or no)
 (organization running log)
 - (8) how well bottom plugged *4"*
plastic cap

CODED

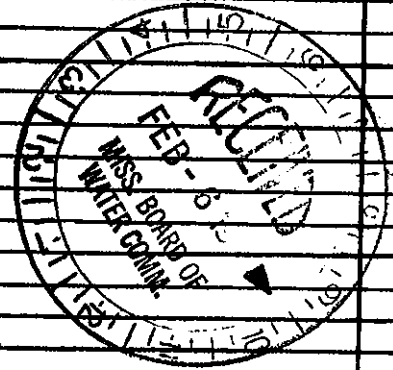

DRILLERS REMARKS: