

BENTON

MISSISSIPPI BOARD OF WATER COMMISSIONERS

A 2000

11-1-61

WATER WELL DRILLERS LOG

Date: 11-1-61, Driller: Robert W. Wilson, County: Benton

(1) Owner of Land: Hubert Bean
 Edms, Miss (Name)
 (Address)

(2) Location: 7 1/4, N 1/4, Sec. 7, T. 1, R. 1
 7 miles, of (distance) (direction) (Nearest Town)

(3) Topography: (Hilly) (Flat) (Level)
 Home

(4) Purpose of Well: (Domestic Irrigation, Municipal, Industrial, Other)

Description & Color of Materials (Sand, Clay, Red Clay, Silts, etc.)	Thick- ness	Depth Feet
Red Clay	20'	0-20'
White Sand	200'	20-220'

Information upon completion of well:

(1) Diameter 4 inches.

(2) Total Depth 220 feet.

(3) Water Level 170' feet below top of ground.

(4) Cased to 220, Size 4"


(5) Screen: Size 4, Length 6'

(6) Were any formations sealed against pollution?
 X
 yes, no.

If YES depth of formation _____

Why _____

Drillers Remarks: _____

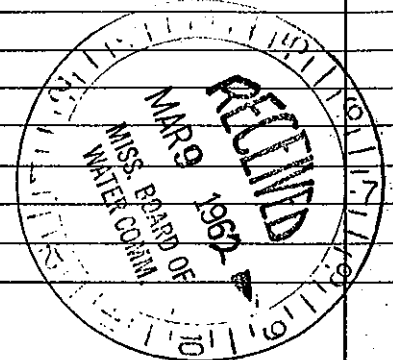

(Use Back Side)

Well No.

Mail this copy to Board of Water Commissioners 429 Miss. St. Jackson, Miss.