

MISSISSIPPI BOARD OF WATER COMMISSIONERS

**BENTON**

**A 2003**

**WATER WELL DRILLERS LOG**

**4-18-62**

Date: April 18, 1962, Driller: Robert W. Wilson County Benton  
(Name)

(1) Owner of Land: <u>Walter Moore</u> <small>(Name)</small>	Description & Color of Materials Sand, Clay, Red Clay, Shell, etc.	Thick- ness Feet	Depth Feet
<u>Michigan City, Tenn.</u> <small>(Address)</small>	<u>Red Clay</u>	<u>40</u>	<u>0-40</u>
(2) Location: <u>1/4, 1/4, Sec. T R</u>	<u>White Clay</u>	<u>30</u>	<u>40-70</u>
<u>4</u> miles <u>SW</u> of <u>Michigan City</u> <small>(distance) (direction) (Nearest Town)</small>	<u>White Sand</u>	<u>60</u>	<u>70-130</u>
(3) Topography: <u>X</u> <small>(Hilly) (Flat) (Level)</small>			
(4) Purpose of Well: <small>(Domestic Irrigation Municipal, Industrial, Other)</small>			


Information upon completion of well:

- (1) Diameter 4 inches.
- (2) Total Depth 130' feet.
- (3) Water Level 80' feet below top of ground.
- (4) Cased to 130', Size 4"
- (5) Screen: Size 4", Length 6'
- (6) Were any formations sealed against pollution?  
no, X yes.

If YES depth of formation \_\_\_\_\_

Why \_\_\_\_\_

Drillers Remarks: \_\_\_\_\_

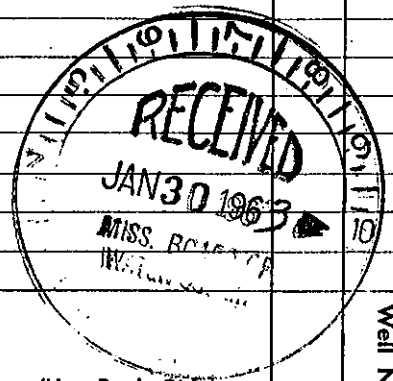

(Use Back Side)

Well No.

Mail this copy to Board of Water Commissioners 429 Miss. St. Jackson, Miss.