


BENTON MISSISSIPPI BOARD OF WATER COMMISSIONERS

A 2004
10-10-63

WATER WELL DRILLERS LOG

Date: 10-10, 1963, Driller: R. W. Wilson County Benton
(Name)

(1) Owner of Land: <u>Michigan City Gin Co.</u> (Name)	Description & Color of Materials Sand, Clay, Red Clay, Shell, etc.	Thick- ness Feet	Depth Feet
<u>Michigan City</u> (Address)	<u>Red sand</u>	<u>20</u>	<u>0-20</u>
(2) Location: _____ 1/4, _____ 1/4, Sec. _____ T _____ R _____	<u>White "</u>	<u>50</u>	<u>20-7</u>
_____ miles _____, of <u>Michigan City</u> (distance) (direction) (Nearest Town)			
(3) Topography: <u>X</u> (Hilly) (Flat) (Level)			
(4) Purpose of Well: <u>Domestic</u> (Domestic Irrigation Municipal, Industrial, Other)			
Information upon completion of well:			
(1) Diameter <u>4</u> inches.			
(2) Total Depth <u>70</u> feet.			
(3) Water Level _____ feet below top of ground.			
(4) Cased to <u>70</u> , Size <u>4</u>			
(5) Screen: Size <u>4</u> , Length <u>6</u>			
(6) Were any formations sealed against pollution? _____ yes, <u>X</u> no.			
If YES depth of formation _____			
Why _____			
Drillers Remarks: _____			

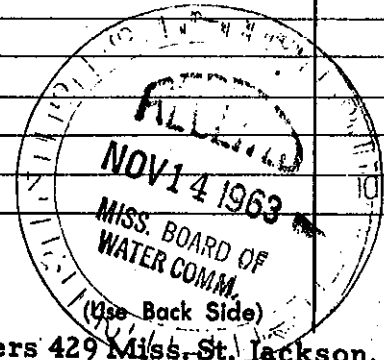

Well No.

Mail this copy to Board of Water Commissioners 429 Miss. St. Jackson, Miss.