

BENTON MISSISSIPPI BOARD OF WATER COMMISSIONERS

A 2005

WATER WELL DRILLERS LOG

10-18-63

Date: 10-18, 1963, Driller: R. W. Wilson County Benton

(Name)

	Description & Color of Materials Sand, Clay, Red Clay, Shell, etc.	Thick- ness Feet	Depth Feet
(1) Owner of Land: <u>Clarence Williams</u> (Name)	<u>Red Sand</u>	<u>80</u>	<u>0-80</u>
<u>Michigan City, Miss.</u> (Address)	<u>White "</u>	<u>32</u>	<u>80-112</u>
(2) Location: _____ 1/4, _____ 1/4, Sec. _____ T. R. _____			
_____ miles _____, of _____ (distance) (direction) (Nearest Town)			
(3) Topography: _____ (Hilly) (Flat) (Level)			
(4) Purpose of Well: <u>Domestic</u> (Domestic Irrigation Municipal, Industrial, Other)			


Information upon completion of well:

- (1) Diameter 4 inches.
- (2) Total Depth 112 feet.
- (3) Water Level 90 feet below top of ground.
- (4) Cased to 112, Size 4.
- (5) Screen: Size 4", Length 6'.
- (6) Were any formations sealed against pollution?
_____ yes, X no.

If YES depth of formation _____

Why _____

Drillers Remarks: _____

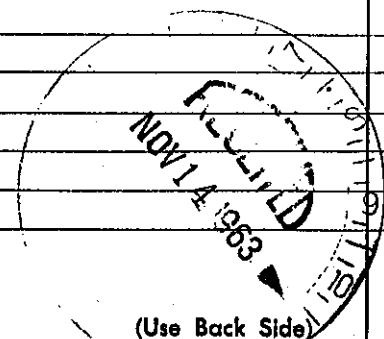

(Use Back Side)

Well No.

Mail this copy to Board of Water Commissioners 429 Miss. St. Jackson, Miss.