

MISSISSIPPI BOARD OF WATER COMMISSIONERS

BENTON

A 2006 WATER WELL DRILLERS LOG

9-30-63

Date: 9-30, 1963, Driller: R. W. Wilson County Benton

(Name)

(1) Owner of Land: <u>Walker Lewis</u> (Name)	Description & Color of Materials Sand, Clay, Red Clay, Shell, etc.	Thick- ness Feet	Depth Feet
<u>Michigan City</u> (Address)	<u>Red Sand</u>	<u>35</u>	<u>0-35'</u>
	<u>" " + clay</u>	<u>20</u>	<u>35-55'</u>
	<u>" "</u>	<u>32</u>	<u>55-87'</u>
(2) Location: <u>1/4</u> , <u>1/4</u> , Sec. <u> </u> T. <u> </u> R. <u> </u>			
<u>1/4</u> miles <u>E</u> , of <u>Michigan City</u> (distance) (direction) (Nearest Town)			
(3) Topography: <u> </u> (Hilly) (Flat) (Level)			
(4) Purpose of Well: <u>Domestic</u> (Domestic Irrigation Municipal, Industrial, Other)			

Information upon completion of well:

(1) Diameter 4 inches.

(2) Total Depth 87 feet.

(3) Water Level _____ feet below top of ground.

(4) Cased to 87, Size 4


(5) Screen: Size 4, Length 6

(6) Were any formations sealed against pollution?
_____ yes, X no.

If YES depth of formation _____

Why _____

Drillers Remarks: _____

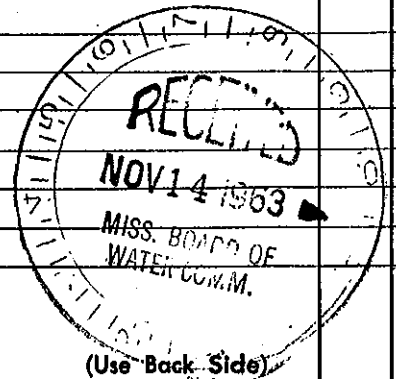

Well No.

Mail this copy to Board of Water Commissioners 429 Miss. St. Jackson, Miss.