

BENTON MISSISSIPPI BOARD OF WATER COMMISSIONERS

A 2010

WATER WELL DRILLERS LOG

6-16-64

Date: 6-16, 1964, Driller: Robert W. Wilson, County Benton

(Name)

	Description & Color of Materials Sand, Clay, Red Clay, Shell, etc.	Thick- ness Feet	Depth Feet
(1) Owner of Land: John Mason (Name)	Red Dirt	0	10
Michigan City (Address)	" sand	10	30
(2) Location: 1/4, 1/4, Sec. T R	white clay & sand	30	40
_____ miles _____ of Michigan City (distance) (direction) (Nearest Town)	" sand	40	68
(3) Topography: <input checked="" type="checkbox"/> (Hilly) <input type="checkbox"/> (Flat) <input type="checkbox"/> (Level)			
(4) Purpose of Well: Domestic (Domestic Irrigation, Municipal, Industrial, Other)			

Information upon completion of well:


- (1) Diameter 4 inches.
- (2) Total Depth 68 feet.
- (3) Water Level 37 feet below top of ground.
- (4) Cased to 68, Size 4
- (5) Screen: Size 4, Length 4
- (6) Were any formations sealed against pollution?
_____ yes, X no.

If YES depth of formation _____

Why _____

Drillers Remarks: _____

Mail this copy to Board of Water Commissioners 429 Miss. St. Jackson, Mis:

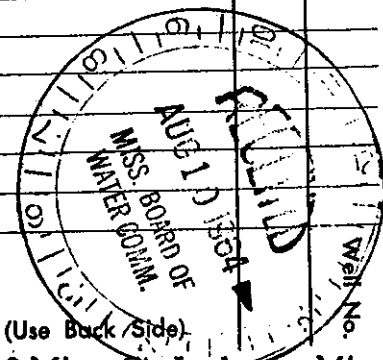

(Use Back Side)