

BENTON MISSISSIPPI BOARD OF WATER COMMISSIONERS

A 2011
9-1-64

WATER WELL DRILLERS LOG

Date: Sept. 1, 1964, Driller: Robert W. Wilson County Benton
(Name)


		Description & Color of Materials Sand, Clay, Red Clay, Shell, etc.	Thick- ness Feet	Depth Feet
(1) Owner of Land: <u>DeHerman Avant</u> <small>(Name)</small>		<u>Red clay</u>	<u>10</u>	<u>10</u>
<u>Michigan City</u> <small>(Address)</small>		<u>" sand</u>	<u>20</u>	<u>30</u>
(2) Location: <u>1/4</u> , <u>1/4</u> , Sec. <u>T R</u> <u>Interscated</u>		<u>white clay</u>	<u>10</u>	<u>40</u>
<u>1</u> miles <u>E</u> , of <u>7472</u> <small>(distance) (direction) (Nearest Town)</small>		<u>yellow sand</u>	<u>10</u>	<u>50</u>
(3) Topography: <input checked="" type="checkbox"/> <u>Hilly</u> <input type="checkbox"/> <u>Flat</u> <input checked="" type="checkbox"/> <u>Level</u>		<u>white "</u>	<u>35</u>	<u>85</u>
(4) Purpose of Well: <u>Domestic</u> <small>(Domestic Irrigation Municipal, Industrial, Other)</small>				

Information upon completion of well:

- (1) Diameter 4 inches.
- (2) Total Depth 85 feet.
- (3) Water Level 40 feet below top of ground.
- (4) Cased to 85, Size 4.
- (5) Screen: Size 6, Length 4.
- (6) Were any formations sealed against pollution?
no, yes.

YES depth of formation _____
 why _____

Drillers Remarks: _____

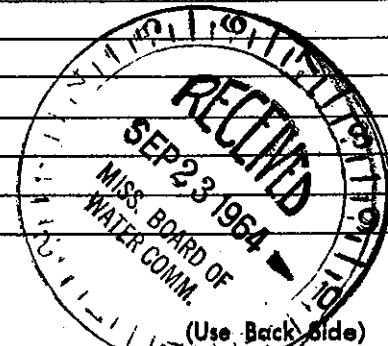

Well No.

Mail this copy to Board of Water Commissioners 429 Miss. St. Jackson, Miss