


BENTON MISSISSIPPI BOARD OF WATER COMMISSIONERS

A 2014
11-9-64

WATER WELL DRILLERS LOG

Date: Nov. 9, 1964, Driller: Robert Wilson County Benton
 (Name)

| | Description & Color of Materials Sand, Clay, Red Clay, Shell, etc. | Thick- ness Feet | Depth Feet |
|---|---|------------------------|---------------|
| (1) Owner of Land: <u>Aldrich Stelton</u> (Name) | <u>Red dirt</u> | <u>10</u> | <u>10</u> |
| <u>Michigan City</u> (Address) | <u>" sand</u> | <u>20</u> | <u>30</u> |
| (2) Location: <u>1/4</u> , <u>1/4</u> , Sec. <u>T</u> <u>R</u> | <u>" clay & sand</u> | <u>10</u> | <u>40</u> |
| <u>1</u> miles <u>W</u> , of <u>Liberty Church</u> (distance) (direction) (Nearest Town) | <u>White sand</u> | <u>10</u> | <u>50</u> |
| (3) Topography: <u>A</u> (Hilly) (Flat) (Level) | <u>" clay</u> | <u>60</u> | <u>110</u> |
| (4) Purpose of Well: <u>Domestic</u> (Domestic Irrigation Municipal, Industrial, Other) | <u>" " & sand</u> | <u>20</u> | <u>130</u> |
| | <u>Blue clay</u> | <u>40</u> | <u>170</u> |
| | <u>" " & sand</u> | <u>10</u> | <u>180</u> |
| | <u>Green sand</u> | <u>13</u> | <u>193</u> |
| Information upon completion of well: | | | |
| (1) Diameter <u>4</u> inches. | | | |
| (2) Total Depth <u>193</u> feet. | | | |
| (3) Water Level <u>100</u> feet below top of ground. | | | |
| (4) Cased to <u>193</u> , Size <u>4</u> | | | |
| (5) Screen: Size <u>6</u> , Length <u>4</u> | | | |
| (6) Were any formations sealed against pollution? | | | |
| <u> </u> yes, <u>X</u> no. | | | |
| If YES depth of formation _____ | | | |
| Why _____ | | | |
| Drillers Remarks: _____ | | | |
| _____ | | | |
| _____ | | | |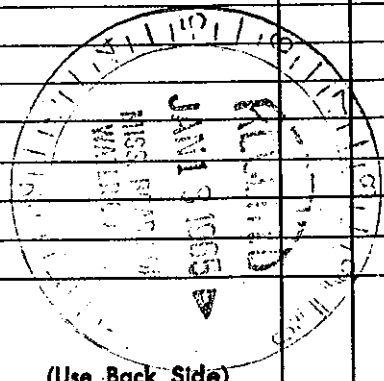
(Use Back Side)

Well No.

Mail this copy to Board of Water Commissioners 429 Miss. St. Jackson, Miss