


**BENTON** MISSISSIPPI BOARD OF WATER COMMISSIONERS

**A** 2015  
10-12-64

**WATER WELL DRILLERS LOG**

Date: Oct. 12, 1964, Driller: Robert W. Wilson County Benton  
(Name)

(1) Owner of Land: <u>Cotton Patch Cafe</u> (Name)	Description & Color of Materials Sand, Clay, Red Clay, Shell, etc.	Thick- ness Feet	Depth Feet
<u>Michigan City</u> (Address)	Red clay	10	10
	" sand	10	20
	White sand	45	65
(2) Location: <u>1/4</u> , <u>1/4</u> , Sec. <u>T R</u> , <u>Intersection</u> miles _____, of <u>7+72</u> , (distance) (direction) (Nearest Town)			
(3) Topography: <u>X</u> (Hilly) (Flat) (Level)			
(4) Purpose of Well: <u>Domestic</u> (Domestic Irrigation Municipal, Industrial, Other)			
Information upon completion of well:			
(1) Diameter <u>4</u> inches.			
(2) Total Depth <u>62</u> feet.			
(3) Water Level <u>30</u> feet below top of ground.			
(4) Cased to <u>62</u> , Size <u>4</u>			
(5) Screen: Size <u>4</u> , Length <u>4</u>			
(6) Were any formations sealed against pollution?			
_____ yes, <u>X</u> no.			
If YES depth of formation _____			
Why _____			
Drillers Remarks: _____			
_____			
_____			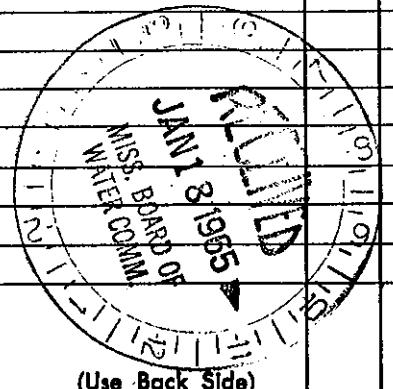
(Use Back Side)

Well No.

Mail this copy to Board of Water Commissioners 429 Miss. St. Jackson, Miss.