


**BENTON** MISSISSIPPI BOARD OF WATER COMMISSIONERS

**A** 2016

**2-16-65** WATER WELL DRILLERS LOG

Date: Feb 16, 1965, Driller: R. W. Wilson County Benton  
(Name)

(1) Owner of Land: <u>Frank Elmore</u> <small>(Name)</small>	Description & Color of Materials Sand, Clay, Red Clay, Shell, etc.	Thick- ness Feet	Depth Feet
<u>Michigan City</u> <small>(Address)</small>	<u>white dirt</u>	<u>10</u>	<u>10</u>
	<u>Red "</u>	<u>20</u>	<u>30</u>
	<u>" sand</u>	<u>60</u>	<u>90</u>
(2) Location: <u>1/4</u> , <u>1/4</u> , Sec. <u>   </u> T. <u>   </u> R. <u>   </u>	<u>white "</u>	<u>35</u>	<u>115</u>
<u>4</u> miles <u>W</u> of <u>Michigan City</u> <small>(distance) (direction) (Nearest Town)</small>			
(3) Topography: <u>   </u> <small>(Hilly) (Flat) (Level)</small>			
(4) Purpose of Well: <u>Domestic</u> <small>(Domestic Irrigation Municipal, Industrial, Other)</small>			
Information upon completion of well:			
(1) Diameter <u>4</u> inches.			
(2) Total Depth <u>115</u> feet.			
(3) Water Level <u>85</u> feet below top of ground.			
(4) Cased to <u>115</u> , Size <u>4</u>			
(5) Screen: Size <u>6</u> , Length <u>4</u>			
(6) Were any formations sealed against pollution? <u>   </u> yes, <u>X</u> no.			
If YES depth of formation _____			
Why _____			
Drillers Remarks: _____			
_____			
_____			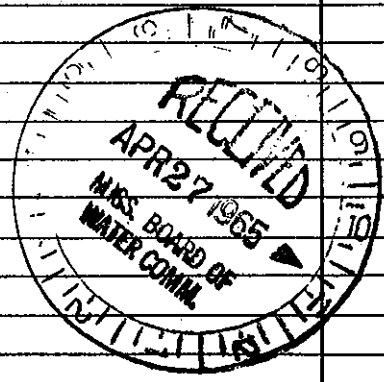
(Use Back Side)

Well No.

Mail this copy to Board of Water Commissioners 429 Miss. St. Jackson, Miss.