

BENTON MISSISSIPPI BOARD OF WATER COMMISSIONERS

A 2017
4-20-65

WATER WELL DRILLERS LOG

Date: Apr 20, 1965, Driller: P.W. Wilson County Benton
(Name)

		Description & Color of Materials Sand, Clay, Red Clay, Shell, etc.	Thick- ness Feet	Depth Feet
(1) Owner of Land: <u>Edson W. Wilson</u> (Name)		<u>Red dirt</u>	<u>20</u>	<u>20</u>
<u>Michigan City</u> (Address)		<u>" sand</u>	<u>50</u>	<u>70</u>
(2) Location: <u>1/4</u> , <u>1/4</u> , Sec. <u>T</u> <u>R</u>		<u>white "</u>	<u>10</u>	<u>80</u>
<u>4</u> miles <u>W</u> , of <u>Michigan City</u> (distance) (direction) (Nearest Town)		<u>" clay</u>	<u>10</u>	<u>90</u>
(3) Topography: <u>X</u> (Hilly) (Flat) (Level)		<u>" sand</u>	<u>25</u>	<u>115</u>
(4) Purpose of Well: <u>Domestic</u> (Domestic Irrigation Municipal, Industrial, Other)				

Information upon completion of well:

(1) Diameter 4 inches.

(2) Total Depth 115 feet.

(3) Water Level 88 feet below top of ground.

(4) Cased to 115, Size 4


(5) Screen: Size 6, Length 4

(6) Were any formations sealed against pollution?
 _____ yes, X no.

If YES depth of formation _____

Why _____

Drillers Remarks: _____

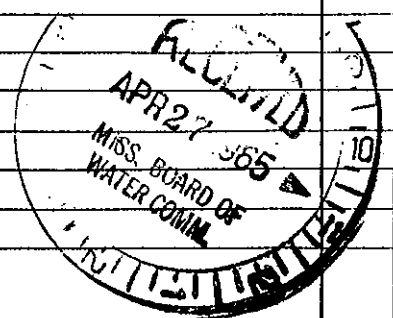

(Use Back Side)

Well No.

Mail this copy to Board of Water Commissioners 429 Miss. St. Jackson, Miss.