

**BENTON** MISSISSIPPI BOARD OF WATER COMMISSIONERS


**A** 2018

**4-20-65**

**WATER WELL DRILLERS LOG**

Date: 4-20, 19 65, Driller: P. W. Wilson County Benton  
(Name)

	Description & Color of Materials Sand, Clay, Red Clay, Shell, etc.	Thick- ness Feet	Depth Feet
(1) Owner of Land: <u>J. P. Marsh</u> <small>(Name)</small>	<u>Red dirt</u>	<u>10</u>	<u>10</u>
<u>Michigan City</u> <small>(Address)</small>	<u>white sand</u>	<u>58</u>	<u>68</u>
(2) Location: <u>1/4</u> , <u>1/4</u> , Sec. <u>T</u> <u>R</u>			
<u>          </u> miles <u>          </u> , of <u>Michigan City</u> <small>(distance) (direction) (Nearest Town)</small>			
(3) Topography: <u>X</u> <small>(Hilly) (Flat) (Level)</small>			
(4) Purpose of Well: <u>Domestic</u> <small>(Domestic Irrigation Municipal, Industrial, Other)</small>			
Information upon completion of well:			
(1) Diameter <u>4</u> inches.			
(2) Total Depth <u>68</u> feet.			
(3) Water Level <u>40</u> feet below top of ground.			
(4) Cased to <u>68</u> , Size <u>4</u>			
(5) Screen: Size <u>6</u> , Length <u>4</u>			
(6) Were any formations sealed against pollution? <u>          </u> yes, <u>X</u> no.			
If YES depth of formation <u>          </u>			
Why <u>          </u>			
Drillers Remarks: <u>          </u>			
<u>          </u>			
<u>          </u>			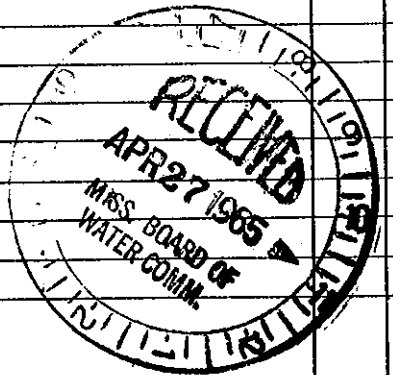
(Use Back Side)

Well No.

Mail this copy to Board of Water Commissioners 429 Miss. St. Jackson, Miss