


BENTON MISSISSIPPI BOARD OF WATER COMMISSIONERS

A 2019
4-27-65

WATER WELL DRILLERS LOG

Date: 4-27, 1965, Driller: ROBERT W. WILSON County BENTON
(Name)

	Description & Color of Materials Sand, Clay, Red Clay, Shell, etc.	Thick- ness Feet	Depth Feet
(1) Owner of Land: <u>LAMAR MILLER</u> (Name)			
<u>MICHIGAN CITY</u> (Address)	<u>RED CLAY</u>	<u>0</u>	<u>10</u>
(2) Location: <u>1/4</u> , <u>1/4</u> , Sec. <u>T</u> <u>R</u>	<u>SAND</u>	<u>10</u>	<u>20</u>
<u>3</u> miles <u>SW</u> , of <u>M.C.</u> (distance) (direction) (Nearest Town)	<u>WHITE SAND + CLAY</u>	<u>20</u>	<u>40</u>
(3) Topography: <u>HILLY</u> (Hilly) (Flat) (Level)		<u>40</u>	<u>75</u>
(4) Purpose of Well: <u>HOME</u> (Domestic Irrigation Municipal, Industrial, Other)			
Information upon completion of well:			
(1) Diameter <u>4</u> inches.			
(2) Total Depth <u>70</u> feet.			
(3) Water Level <u>50</u> feet below top of ground.			
(4) Cased to <u>70</u> , Size <u>4"</u>			
(5) Screen: Size <u>6"</u> , Length <u>4'</u>			
(6) Were any formations sealed against pollution? <u>no</u>			
If YES depth of formation _____			
Why _____			
Drillers Remarks: _____			

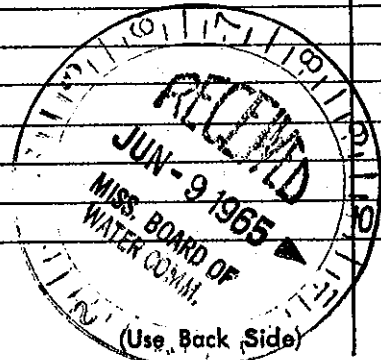

Well No.

Mail this copy to Board of Water Commissioners 429 Miss. St. Jackson, Miss.