

BENTON MISSISSIPPI BOARD OF WATER COMMISSIONERS

A 2021

7-26-65

WATER WELL DRILLERS LOG

Date: 7-26, 1965, Driller: ROBERT W. WILSON County BENTON
(Name)

	Description & Color of Materials Sand, Clay, Red Clay, Shell, etc.	Thick- ness Feet	Depth Feet
(1) Owner of Land: <u>OSCAR OAKLEY</u> (Name)	<u>Red dirt</u>	<u>5</u>	<u>0-5</u>
<u>MICHIGAN CITY, MISS.</u> (Address)	<u>Red sand</u>	<u>15</u>	<u>5-20</u>
(2) Location: <u>1/4</u> , <u>1/4</u> , Sec. <u> </u> T <u> </u> R <u> </u> <u>LOCATED IN MICHIGAN CITY</u> miles <u> </u> of <u> </u> (distance) (direction) (Nearest Town)	<u>White sand</u>	<u>40</u>	<u>20-6</u>
(3) Topography: <u> </u> <input checked="" type="checkbox"/> <u> </u> <input type="checkbox"/> <u> </u> (Hilly) (Flat) (Level)			
(4) Purpose of Well: <u>Domestic</u> (Domestic Irrigation Municipal, Industrial, Other)			


Information upon completion of well:

- (1) Diameter 4 inches.
- (2) Total Depth 67 feet.
- (3) Water Level 30 feet below top of ground.
- (4) Cased to 67, Size 4"
- (5) Screen: Size 6" O.D., Length 4'
- (6) Were any formations sealed against pollution?
 yes, no.

If YES depth of formation

Why

Drillers Remarks:

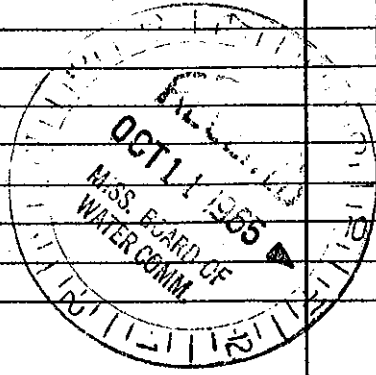

(Use Back Side)

Well No.

Mail this copy to Board of Water Commissioners 429 Miss. St. Jackson, Miss.