

MISSISSIPPI DEPARTMENT OF NATURAL RESOURCES

Bureau of Land and Water Resources

Southport Mall

P.O. Box 10631

Jackson, Mississippi 39209

WATER WELL DRILLERS LOG

BENTON  
A 2036  
5/1/81

MAY

5-4-81  
date well completed

Wilson Well Co  
firm name

Benton  
county well located

LANDOWNER:

Alge ferry  
Rt 1 Bx 296  
Hammer Ms  
(mailing address)

description of formations encountered

from to

Red clay - Red sand	0	30
White clay - white sand	30	60
White sand	60	75

WELL LOCATION:

sec 25 T 1 N R 1 E  
2 miles S of Michigan City  
(distance) (direction) (nearest town)

WELL PURPOSE:

(home, irrigation, municipal, industrial)


WELL COMPLETION DATA:

- (1) diameter (inches) 4
- (2) total depth (feet) 75
- (3) static water level (feet) 30 below top of ground
- (4) casing plastic (material) (depth) 4 (size) If telescope see back.
- (5) screen 10' (length) (depth to top) 4" plastic (size) (material)
- (6) pump 3/4 (HP) 9 (yield gpm) electric (type power)
- (7) electric log NO (yes or no)

(organization running log)

(8) how well bottom plugged Plastic cap 4"

DRILLERS REMARKS:

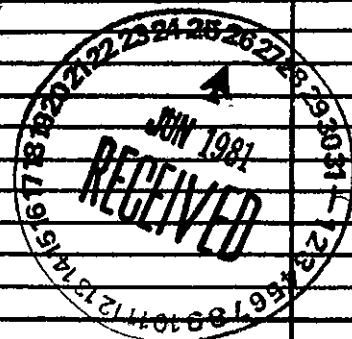

MAY