

MISSISSIPPI DEPARTMENT OF NATURAL RESOURCES

Bureau of Land and Water Resources

Southport Mall

P.O. Box 10631

Jackson, Mississippi 39209

WATER WELL DRILLERS LOG

BENTON
A 2038
4/2/81
4-2-81
 date well completed

Wilson Well Co firm name
BENTON county well located


LANDOWNER:
Alfred Wilburn
Box #1 Box 51
Michigan City, Miss
 (mailing address) 38647

WELL LOCATION:
 sec 33 T 1 N R 1 E
4 miles N of Lamar
 (distance) (direction) (nearest town)

WELL PURPOSE: home
 (home, irrigation, municipal, industrial)

- WELL COMPLETION DATA:
- (1) diameter (inches) 4
 - (2) total depth (feet) 145
 - (3) static water level (feet) 90 below top of ground.
 - (4) casing Plastic 135
 (material) (depth)
4" if telescope see back.
 (size)
 - (5) screen 10 Plastic
 (length) (depth to top)
44 (size) (material)
 - (6) pump 3/4 8
 (HP) (yield gpm)
electric
 (type power)
 - (7) electric log No
 (yes or no)
- (organization running log)
- (8) how well bottom plugged Plastic Cap

description of formations encountered	from	to
Red Clay - Red Sand	0	30
White Clay - Red Sand	30	60
White Sand	60	90
Red Sand	90	105
White Sand - White clay Mix	105	120
White Clay - White Sand	120	135
White Sand	135	150

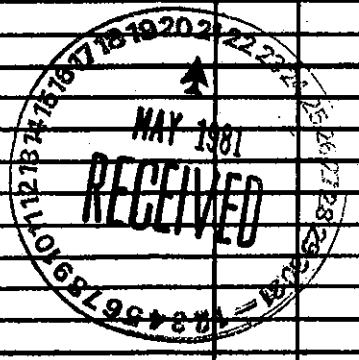

DRILLERS REMARKS: