

MISSISSIPPI DEPARTMENT OF NATURAL RESOURCES

Bureau of Land and Water Resources

Southport Mall

P.O. Box 10631


Jackson, Mississippi 39209

WATER WELL DRILLERS LOG

BENTON
A 2058

11-7 1985 Wilson Well Co. Benton
date well completed firm name county well located

LANDOWNER: <u>Peter Young</u>	description of formations encountered	from	to
<u>Ashland, MS</u> (mailing address)			
WELL LOCATION: sec. <u>25</u> T. <u>1</u> N. R. <u>10</u> E <u>6</u> miles <u>NW</u> of <u>Ashland</u> (distance) (direction) (nearest town)	<u>Topsoil Clay & Red Sand</u> <u>White Clay & White Sand</u> <u>White Clay & White Sand</u> <u>White Sand</u> <u>White Sand</u> <u>White Sand</u> <u>White Sand</u>	<u>0</u> <u>15</u> <u>30</u> <u>40</u> <u>45</u> <u>60</u> <u>75</u>	<u>15</u> <u>30</u> <u>40</u> <u>45</u> <u>60</u> <u>75</u> <u>90</u>
WELL PURPOSE: <u>Home</u> (home, irrigation, municipal, industrial)			
WELL COMPLETION DATA: (1) diameter (inches) <u>4</u> (2) total depth (feet) <u>90</u> (3) static water level (feet) <u>15</u> below above-top of ground. (4) casing <u>PVC</u> <u>80</u> (material) (depth) <u>4"</u> (size) If telescope see back. (5) screen <u>10</u> (length) (depth to top) <u>4"</u> <u>PVC</u> (size) (material) (6) pump <u>3/4</u> (HP) <u>10</u> (yield gpm) <u>elec</u> (type power) (7) electric log <u>no</u> (yes or no) (organization running log) (8) how well bottom plugged <u>4" PVC Cap</u>			
DRILLERS REMARKS:			

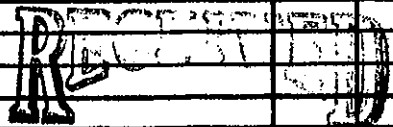

FEB 1 0 1986

Department of Natural Resources
Bureau of Land & Water Resources

2/5/86 @