

Benton
 B10
 5-66

MISSISSIPPI
 BOARD OF WATER COMMISSIONERS
 416 North State Street
 Jackson, Mississippi 39201

WATER WELL DRILLERS LOG

CODED

5-26 1966 Robert W. Wilson
 date well completed firm name county well located

LANDOWNER: John Duncan
 Michigan City
 Miss.
 (mailing address)


| description of formations encountered | from | to |
|---------------------------------------|------|----|
| Red Clay | 0 | 10 |
| Red Sand | 10 | 20 |
| White Sand | 20 | 60 |

WELL LOCATION:
 sec 33 T 1 N R 1 E
 1/4 miles E of Jet.
 (distance) (direction) (nearest town)

WELL PURPOSE:
 (home, irrigation, municipal, industrial)

- WELL COMPLETION DATA:
- diameter (inches) 4"
 - total depth (feet) 60'
 - static water level (feet) 40' ^{below} top of ground.
 - casing Plastic, 56' (material) (depth)
 4" (size) if telescope see back.
 - screen 4' 56' (length) (depth to top)
 20 gal 1/4" Gravel for Slotted Pipe (size) (material)
 - pump 1/2 (HP) (yield gpm)
 Elect. (type power)
 - electric log NO (yes or no)
 (organization running log)
 - how well bottom plugged Plastic Cap 4"

CODED

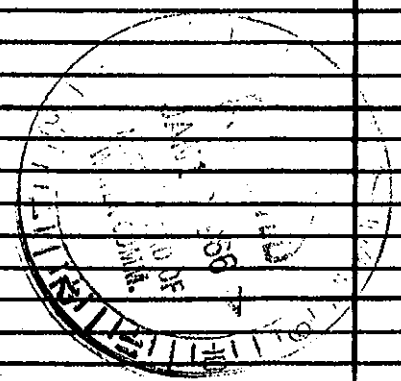

DRILLERS REMARKS: