

BENTON  
 B15  
 4-67

MISSISSIPPI  
 BOARD OF WATER COMMISSIONERS  
 416 North State Street  
 Jackson, Mississippi 39201

**CODED**

WATER WELL DRILLERS LOG

4-17-1967 Robert Wilson Benton  
 date well completed firm name county well located

LANDOWNER: Cater Poplar  
Grand Jet. St.  
Miss.  
 (mailing address)


description of formations encountered	from	to
Red clay	0	10
Red sand	10	80
white sand	80	90
white sand white clay	90	100
white sand	100	120

WELL LOCATION:  
 sec. 13 T. 1 N. R. 1 E  
10 miles E of M. City  
 (distance) (direction) (nearest town)

WELL PURPOSE:  
 (home, irrigation, municipal, industrial)

- WELL COMPLETION DATA:
- (1) diameter (inches) 4"
  - (2) total depth (feet) 122'
  - (3) static water level (feet) 50' below above top of ground.
  - (4) casing plastic, 118'  
 (material) (depth)  
4" if telescope see back.  
 (size)
  - (5) screen 4', 118'  
 (length) (depth to tap)  
4", Gravel pack  
 (size) (material)
  - (6) pump 1/2, 10  
 (HP) (yield gpm)  
Elect.  
 (type power)
  - (7) electric log yes  
 (yes or no)  
 (organization running log)
  - (8) how well bottom plugged 4"  
plastic pap

**CODED**

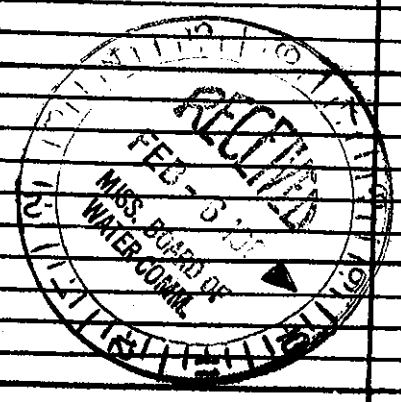

DRILLERS REMARKS: