

Benton  
 B16  
 5-67

MISSISSIPPI  
 BOARD OF WATER COMMISSIONERS  
 416 North State Street  
 Jackson, Mississippi 39201

WATER WELL DRILLERS LOG

**CODED**

5-15 1967 Robert Wilson Benton  
 date well completed firm name county well located

LANDOWNER: Johnny Williams  
 Grand Get. St.  
 Miss.  
 (mailing address)


WELL LOCATION:  
 sec. 25 T 1 N R 1 E  
 S W  
 5 miles E of M. City  
 (distance) (direction) (nearest town)

WELL PURPOSE:  
 (home, irrigation, municipal, industrial)

- WELL COMPLETION DATA:
- (1) diameter (inches) 4"
  - (2) total depth (feet) 162'
  - (3) static water level (feet) 110' below top of ground
  - (4) casing plastic, 158' (material) (depth)  
 4" (size) If telescope see back.
  - (5) screen 4' (length), 158' (depth to top)  
 4" (size), Gravel Pack (material)
  - (6) pump 34 (HP), 18 (yield gpm)  
 Electric (type power)
  - (7) electric log (yes or no)
  - (organization running log) K
  - (8) how well bottom plugged 4"  
 plastic cap

description of formations encountered	from	to
Red clay	0	10
Red Sand	10	20
White clay	20	40
White clay Red Sand	40	50
Red Sand	50	100
Red Sand White clay	100	110
White Sand	110	165

**CODED**

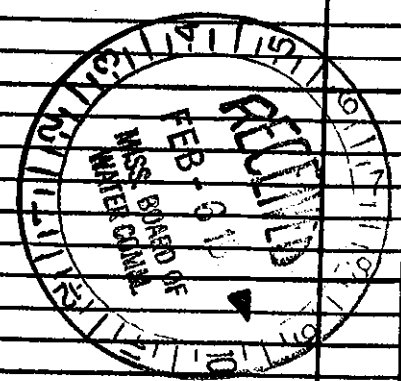

DRILLERS REMARKS: