

Benton
 B17
 9-67

MISSISSIPPI
 BOARD OF WATER COMMISSIONERS
 416 North State Street
 Jackson, Mississippi 39201

WATER WELL DRILLERS LOG

CODED

9-12 1967 Robert Wilson Benton
 date well completed firm name county well located

LANDOWNER: Bill Young
 Michigan City
 Miss.
 (mailing address)


description of formations encountered	from	to
Red clay	0	20
Red Safford	20	40
Red sand white clay	40	50
White Sand	50	84

WELL LOCATION:
 sec. 24 T 1 N 5 R 1 E
5 miles E of Michigan City
 (distance) (direction) (nearest town)

WELL PURPOSE:
 (home, irrigation, municipal, industrial)

- WELL COMPLETION DATA:
- diameter (inches) 4"
 - total depth (feet) 82'
 - static water level (feet) 50 below above top of ground.
 - casing Plastic, 78'
 (material) (depth)
4 if telescope see back.
 (size)
 - screen 4', 78'
 (length) (depth to top)
4, Gravel Pack
 (size) (material)
 - pump 1/2, 10
 (HP) (yield gpm)
Elect.
 (type power)
 - electric log yes or no
✓
 (organization running log)
 - how well bottom plugged 4"
Plastic Cap

CODED

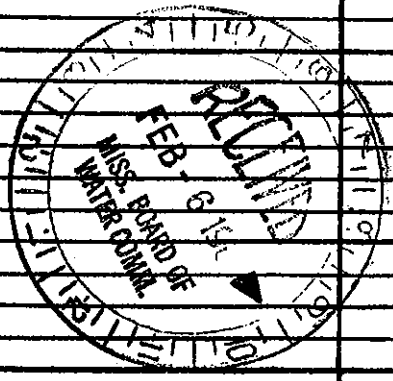

DRILLERS REMARKS: