

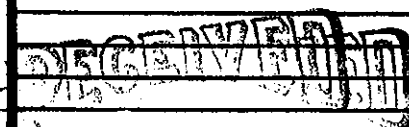
Benton
B 27
10/21/74

MISSISSIPPI
 BOARD OF WATER COMMISSIONERS
 416 North State Street
 Jackson, Mississippi 39201

WATER WELL DRILLERS LOG

CODED

Oct. 21 1974 R.L. Carpenter Benton
 date well completed firm name county well located

LANDOWNER:	description of formations encountered	from	to
<u>James Turner</u>	<u>Surface Soil</u>	<u>8</u>	<u>16</u>
<u>Dual Junction</u>	<u>bed of Fine Red Soil</u>	<u>16</u>	<u>40</u>
<u>Jan. Rt. 2</u> (mailing address)	<u>white fine sand</u>	<u>48</u>	<u>80</u>
WELL LOCATION: sec. <u>25</u> T <u>1</u> N R <u>1</u> E ^{16N} <u>3</u> miles <u>West</u> of <u>Conover</u> (distance) (direction) (nearest town)	<u>white clay</u>	<u>80</u>	<u>93</u>
WELL PURPOSE: (home, irrigation, municipal, industrial)	<u>red white sand</u>	<u>93</u>	<u>120</u>
WELL COMPLETION DATA: (1) diameter (inches) <u>4</u> (2) total depth (feet) <u>144</u> (3) static water level (feet) <u>92</u> above top of ground. (4) casing <u>Plastic</u> , <u>138 ft.</u> (material) (depth) (size) If telescope see back. (5) screen <u>6 ft.</u> , <u>138 ft.</u> (length) (depth to top) <u>4 in.</u> , <u>Plastic</u> (size) (material) (6) pump <u>1/2</u> <u>9</u> (HP) (yield gpm) <u>Elec.</u> (type power) (7) electric log <u>No.</u> (yes or no) (organization running log) (8) how well bottom plugged <u>Plastic</u>	<u>white coarse sand</u>	<u>120</u>	<u>144</u>
DRILLERS REMARKS:	 JUL 21 1975 S. BD. OF WATER COMM. WATER CONSERVATION		