

BENTON  
B 2000

WATER WELL DRILLERS LOG

3-3-61

Date: 19 61, Driller:

Robert W. Wilson

County: Benton

(Name)

(1) Owner of Land:

R.A. Faulkenberry Jr.

(Name)

Grand Junction, Tenn.

(Address)

(2) Location:

1/4, 1/4, Sec. 15 1E

7

S.

G. Junction

miles

of

(distance)

(direction)

(Nearest Town)

(3) Topography:

(Hilly)

None

(Level)

(4) Purpose of Well:

(Domestic Irrigation, Municipal, Industrial, Other)

Information upon completion of well:

(1) Diameter 4 inches.

(2) Total Depth 90 feet.

(3) Water level 60 feet below top of ground.

(4) Cased to 90, Size 4"

(5) Screen: Size 4", Length 6'

(6) Were any formations sealed against pollution?

yes, no.

If YES depth of formation

Why

Drillers Remarks:


Description & Color of Materials  
Sand, Clay, Red Clay, Shell, etc.

Brown sand

Thick-  
ness

90-100

Depth  
Feet

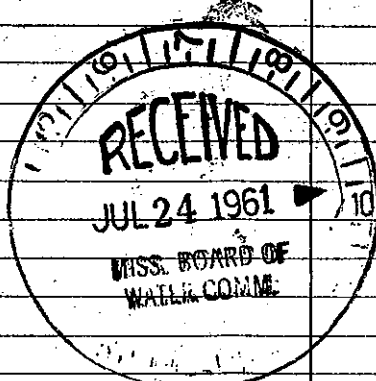

(Use Back Side)

Mail this copy to Board of Water Commissioners 429 Miss. St. Jackson, Miss.

Well No.