

BENTON MISSISSIPPI BOARD OF WATER COMMISSIONERS

B 2006
10-64

WATER WELL DRILLERS LOG

Date: Oct, 1964, Driller: Robert W. Wilson County Benton

(Name)

	Description & Color of Materials Sand, Clay, Red Clay, Shell, etc.	Thick- ness Feet	Depth Feet
(1) Owner of Land: <u>Claude Conley</u> (Name) <u>Grand Junction, Tenn.</u> (Address)	<u>White clay</u>	<u>10</u>	<u>10</u>
	<u>Red sand</u>	<u>60</u>	<u>70</u>
	<u>white "</u>	<u>55</u>	<u>125</u>
(2) Location: <u>1/4</u> , <u>1/4</u> , Sec. <u>T</u> <u>R</u> , <u>4</u> miles <u>S</u> of <u>Grand Jet</u> , (distance) (direction) (Nearest Town)			
(3) Topography: <u>X</u> (Hilly) (Flat) (Level)			
(4) Purpose of Well: <u>Domestic</u> (Domestic Irrigation Municipal, Industrial, Other)			


Information upon completion of well:

- (1) Diameter 4 inches.
- (2) Total Depth 125 feet.
- (3) Water Level 80 feet below top of ground.
- (4) Cased to 125, Size 4.
- (5) Screen: Size 6, Length 4.
- (6) Were any formations sealed against pollution?
_____ yes, 1 no.

If YES depth of formation _____

Why _____

Drillers Remarks: _____

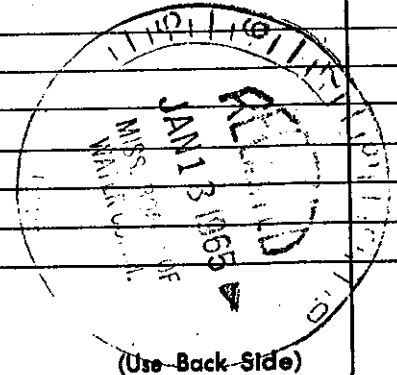

(Use Back Side)

Well No.

Mail this copy to Board of Water Commissioners 429 Miss. St. Jackson, Miss.