


**BENTON** MISSISSIPPI BOARD OF WATER COMMISSIONERS

**B** 2002  
10-64

**WATER WELL DRILLERS LOG**

Date: Oct, 1964, Driller: Robert Wilson County Benton  
(Name)

(1) Owner of Land: <u>Maso Gibson</u> (Name)	Description & Color of Materials Sand, Clay, Red Clay, Shell, etc.	Thick- ness Feet	Depth Feet
<u>Grand Junction, Tenn</u> (Address)	<u>Red clay</u>	<u>10</u>	<u>10</u>
(2) Location: <u>1/4</u> , <u>1/4</u> , Sec. <u>    </u> T <u>    </u> R <u>    </u>	<u>" sand</u>	<u>20</u>	<u>30</u>
<u>5</u> miles <u>S</u> of <u>Grand Jet.</u> (distance) (direction) (Nearest Town)	<u>white clay</u>	<u>10</u>	<u>40</u>
(3) Topography: <u>X</u> (Hilly) (Flat) (Level)	<u>Red sand</u>	<u>80</u>	<u>120</u>
(4) Purpose of Well: <u>Domestic</u> (Domestic Irrigation Municipal, Industrial, Other)	<u>white sand</u>	<u>40</u>	<u>160</u>
Information upon completion of well:			
(1) Diameter <u>4</u> inches.			
(2) Total Depth <u>160</u> feet.			
(3) Water Level <u>120</u> feet below top of ground.			
(4) Cased to <u>160</u> , Size <u>4</u>			
(5) Screen: Size <u>6</u> , Length <u>4</u>			
(6) Were any formations sealed against pollution?			
<u>    </u> yes, <u>X</u> no.			
If YES depth of formation _____			
Why _____			
Drillers Remarks: _____			
_____			
_____			
_____			
_____			

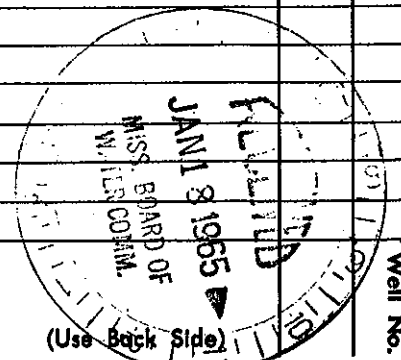

Well No. \_\_\_\_\_

(Use Back Side)

Mail this copy to Board of Water Commissioners 429 Miss. St. Jackson, Miss.