

BENTON MISSISSIPPI BOARD OF WATER COMMISSIONERS

B 2008
9-9-64

WATER WELL DRILLERS LOG

Date: Sept. 9, 1964, Driller: Robert W Wilson County Benton
(Name)

		Description & Color of Materials Sand, Clay, Red Clay, Shell, etc.	Thick- ness Feet	Depth Feet
(1) Owner of Land:	<u>Gena Tapp</u> (Name)			
	<u>Michigan City</u> (Address)	<u>white clay</u>	<u>10</u>	<u>10</u>
		<u>" sand</u>	<u>32</u>	<u>42</u>
(2) Location:	<u>1/4</u> , <u>1/4</u> , Sec. <u>T</u> <u>R</u>			
	<u>1/2</u> miles <u>NE</u> , of <u>Hwy 5472</u> (distance) (direction) (Nearest Town)			
(3) Topography:	<u>X</u> (Hilly) (Flat) (Level)			
(4) Purpose of Well:	<u>Domestic</u> (Domestic Irrigation Municipal, Industrial, Other)			


Information upon completion of well:

- (1) Diameter 4 inches.
- (2) Total Depth 42 feet.
- (3) Water Level 20 feet below top of ground.
- (4) Cased to 42, Size 4
- (5) Screen: Size 4, Length 6
- (6) Were any formations sealed against pollution?
_____ yes, X no.

If YES depth of formation _____

Why _____

Drillers Remarks: _____

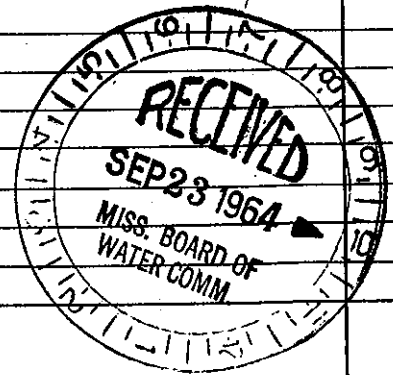

(Use Back Side)

Well No.

Mail this copy to Board of Water Commissioners 429 Miss. St. Jackson, Miss.